


Cross Section : B
74 of 116

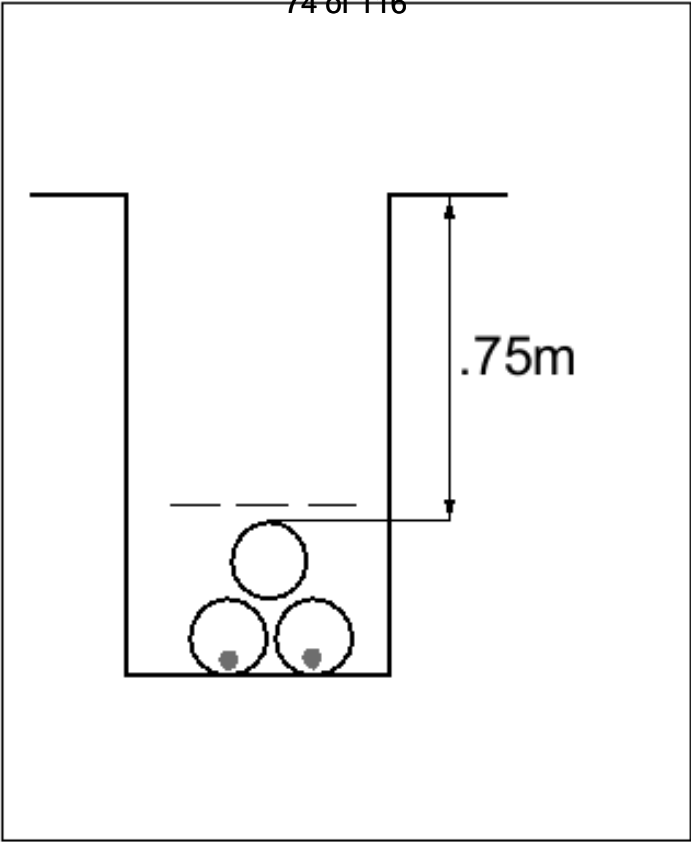

Cross Section
B

1. The position of the apparatus shown on this drawing is believed to be correct but the original landmarks may have been altered since the apparatus was installed.
2. The exact position of the apparatus should be verified - use approved cable avoidance tools prior to excavation using suitable hand tools.
3. It is essential that trial holes are carefully made avoiding the use of mechanical tools or picks until the exact location of all the cables have been determined.
4. It must be assumed that there is a service cable into each property, lamp column and street sign, etc.
5. All cables must be treated as being live unless proved otherwise by UK Power Networks.
6. The information proved must be given to all people working near UK Power Networks plant and equipment. Do not use plans more than 3 months after the issue date for excavation purposes.
7. Please be aware that electric cables/lines belonging to other owners of licensed electricity distribution systems may be present and it is your responsibility to identify their location.

1. UK Power Networks does not warrant that the information provided to you is correct. You rely upon it at your own risk.
2. UK Power Networks does not exclude or limit its liability if it causes the death of any persons or causes personal injury to a person.
3. Subject to paragraph 2 UK Power Networks has no liability to you in contract, in tort (including negligence), for breach of statutory duty or otherwise for any loss, damage, cost, claims, demands, or expenses that you or any third party may suffer or incur as a result of using the information provided whether for physical damage to property or for any economic loss (including without limitation loss of profit, loss of opportunity, loss of savings, loss of goodwill, loss of business, loss of use) or any special or consequential loss or damage whatsoever.
4. This plan has been provided to you on the basis of the terms of use set out in the covering letter that accompanies this plan. If you do not accept and/or do not understand the terms of use set out in the covering letter you must not use the plan and must return it to the sender of the letter.
5. You are responsible for the security of the information provided to you. It must not be given, sold or made available upon payment of a fee to a third party.

IF IN DOUBT - ASK! PHONE
0800 056 5866
EMERGENCY - If you damage
a cable or line
Phone 0800 783 8838 (24hrs)
URGENTLY




ALWAYS LOOK UP BEFORE
YOU START WORK
Refer to HSE Guidance note GS6

Maps produced at 1:2500 scale are Geo-Schematics which show LV mains cables and overhead lines (in some cases all voltages). Prior to carrying out excavations you must refer to the 1:500 records to determine the location of all known underground plant and equipment.


4. SGN

The following site utility layouts have been directly obtained from Groundwise Searches Ltd which depicts the present gas utilities within the vicinity of the IBC site boundary.

Do not proceed until spoken with the asset owner. SGN have a high-risk asset in the vicinity of these proposed works. In order to evaluate the impact of your works on our asset please could you provide further details of your work to plantlocation@sgn.co.uk or [08009121722](tel:08009121722). Please note that until we receive this information and have replied back to you, no works should occur within the vicinity of the pipeline. The pipeline is of prime importance to the gas supplies of this area.

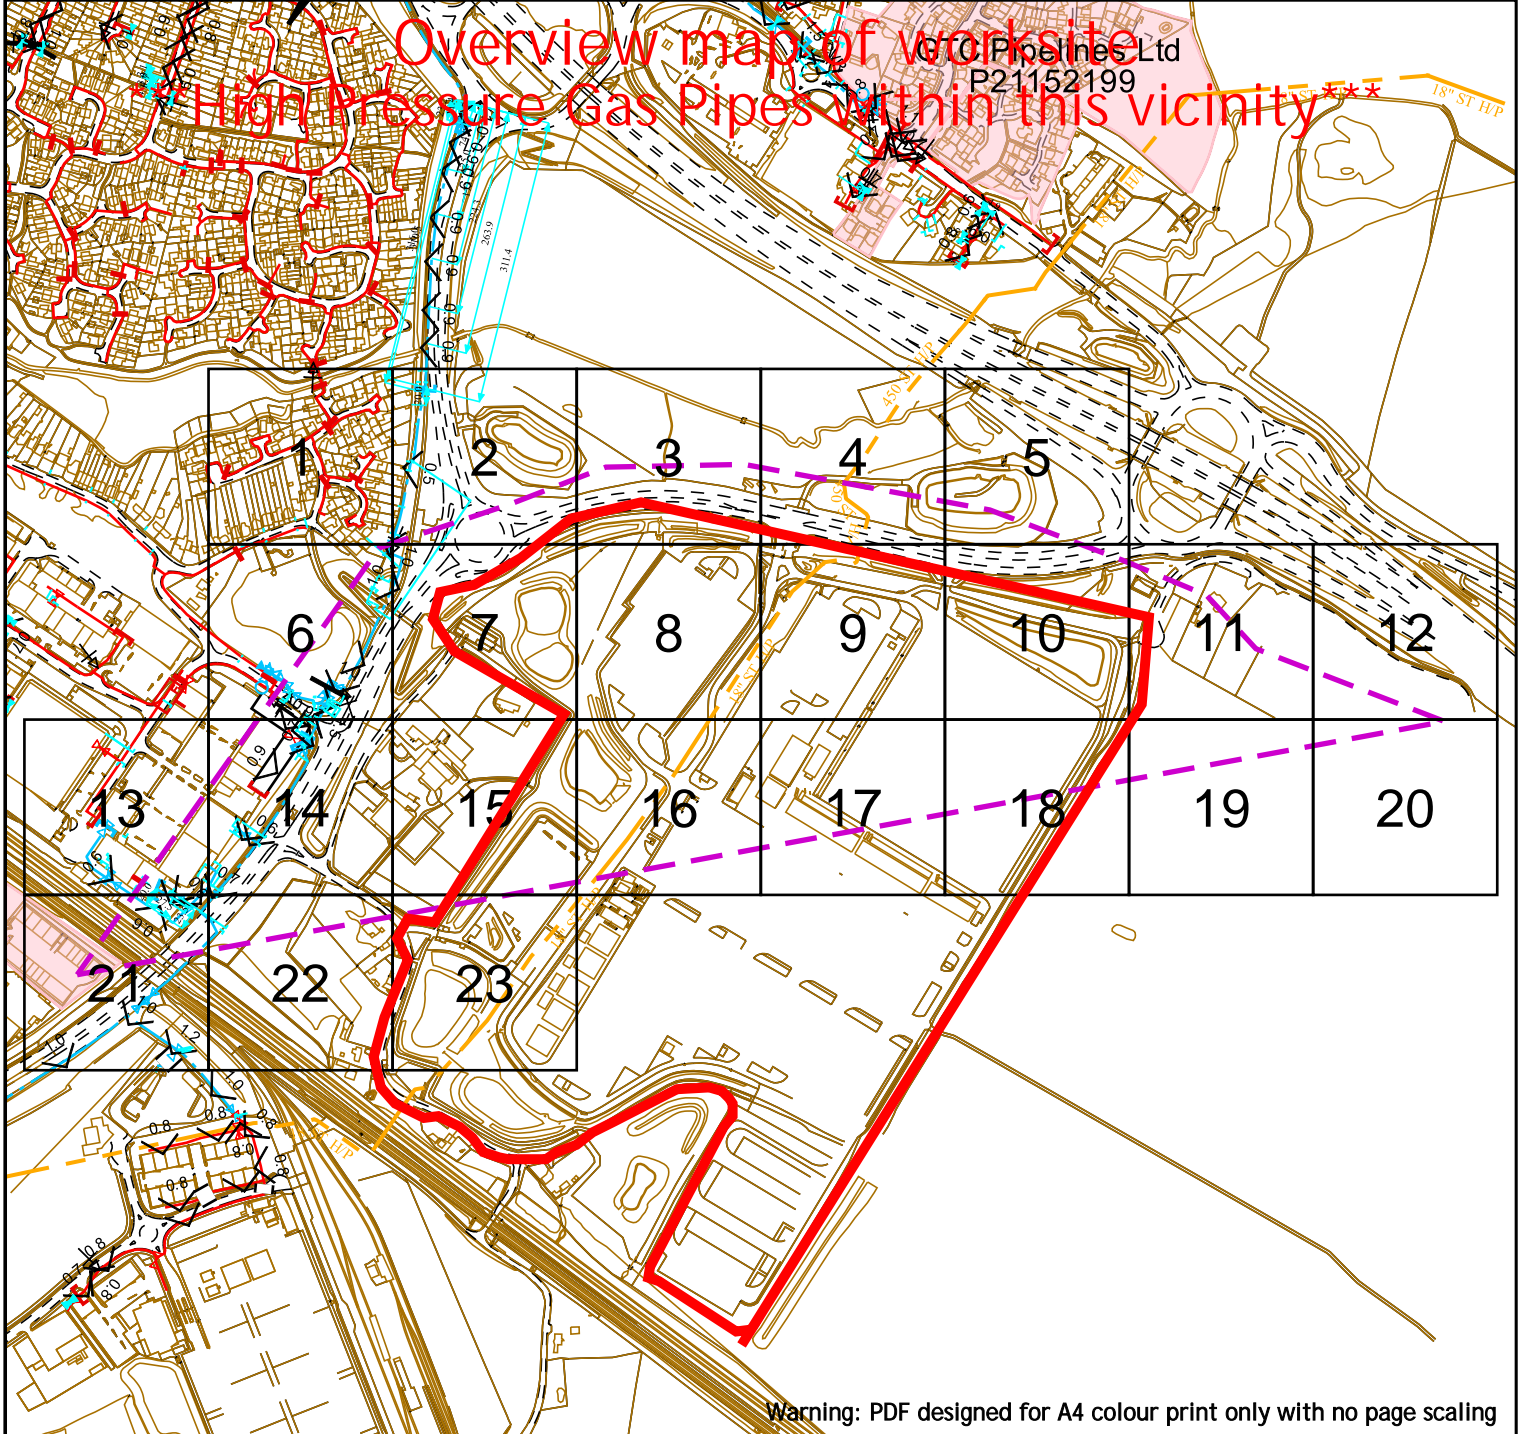

Contact Us
SGN Safety Admin Team:
0800 912 1722
Email:
plantlocation@sgn.co.uk

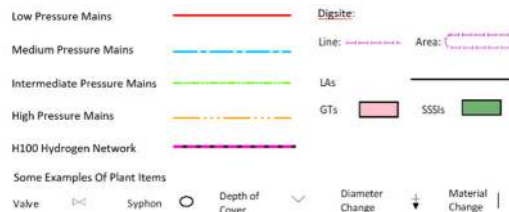

This information is given as a guide only and its accuracy cannot be guaranteed.



This plan shows the location of those pipes owned by Scotia Gas Networks (SGN) by virtue of being a licensed Gas Transporter (GT). Gas pipes owned by other GTs or third parties may also be present in this area but are not shown on this plan. Information with regard to such pipes should be obtained from the relevant owners. No warranties are given with regard to the accuracy of the information shown on this plan. Service pipes, valves, siphons, sub-connections etc. are not shown but their presence should be anticipated. You should be aware that a small percentage of our pipes/assets may be undergoing review and will temporarily be highlighted in yellow. If your proposed works are close to one of these pipes, you should contact the SGN Safety Admin Team on 0800 912 1722 for advice. No liability of any kind whatsoever is accepted by SGN or its agents, servants or sub-contractors for any error or omission contained herein. Safe digging practices, in accordance with HS (G)47, must be used to verify and establish the actual position of mains, pipes, services and other apparatus on site before any mechanical plant is used. It is your responsibility to ensure that plant location information is provided to all persons (whether direct labour or sub-contractors) working for you on or near gas apparatus. Information included on this plan should not be referred to beyond a period of 28 days from the date of issue.


Report damage immediately – KEEP EVERYONE AWAY FROM THE AREA
0800 111 999

This plan is reproduced from or based on the OS map by Scotia Gas Networks plc, with the sanction of the controller of the HM Stationery Office. Crown Copyright Reserved. Southern Gas – 100044373 and Scotland Gas – 100044366.

Date Requested: 19/02/2025
Job Reference: 36078720
Site Location: 604023 140875
Requested by: XXXXXXXXXX
Your Scheme/Reference: 37047-2

Scale: 1:8200 (When plotted at A4)

High Pressure Gas Pipes within this vicinity

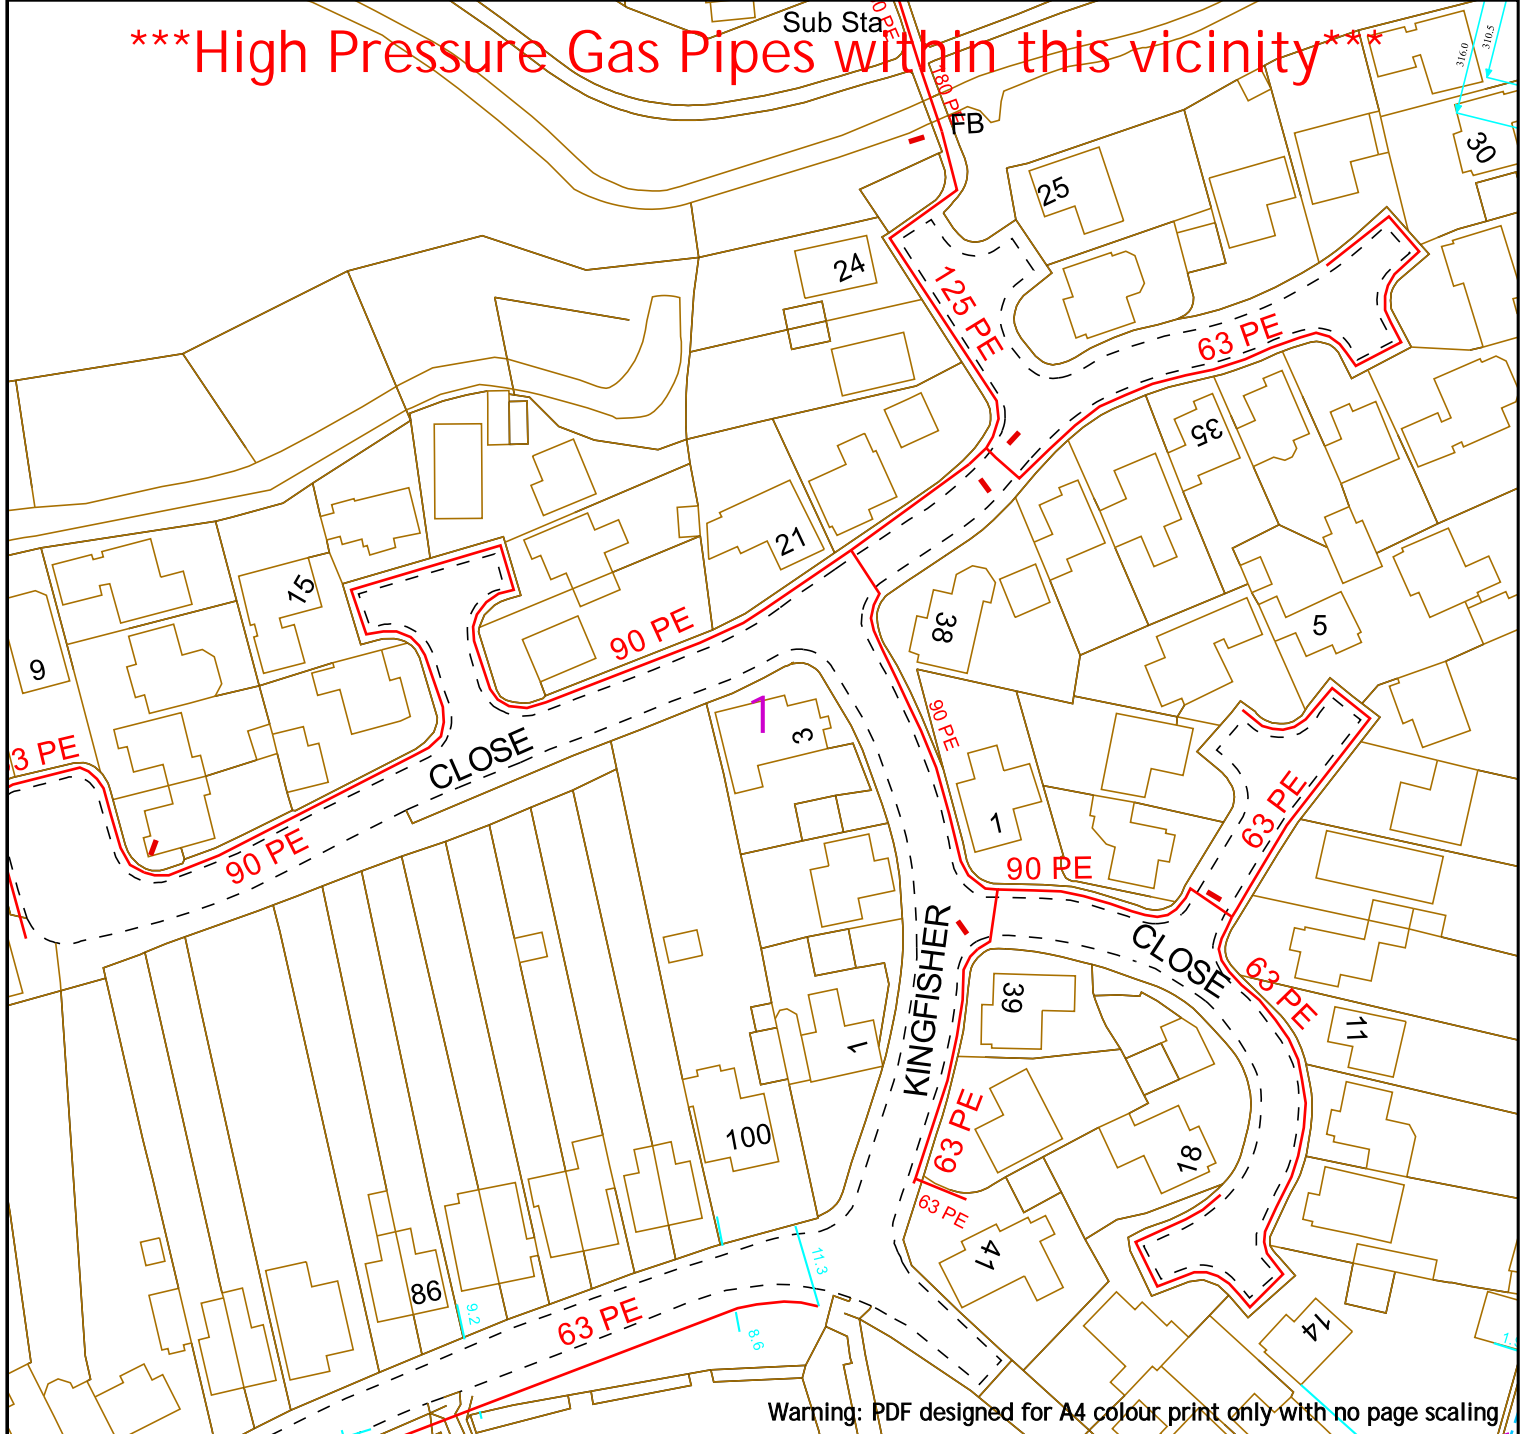

Warning: PDF designed for A4 colour print only with no page scaling



Contact Us
SGN Safety Admin Team:
 0800 912 1722
Email:
plantlocation@sgn.co.uk

Low Pressure Mains	—	Dispute:	Line: —	Area: —
Medium Pressure Mains	—			
Intermediate Pressure Mains	—	LAIs	—	
High Pressure Mains	—	GTs	—	SSSIs
H100 Hydrogen Network	—			
Some Examples Of Plant Items				
Valve	—	Syphon	—	Depth of Cover
	—		—	Diameter Change
	—		—	Material Change



This information is given as a guide only and its accuracy cannot be guaranteed.




This plan shows the location of those pipes owned by Scotia Gas Networks (SGN) by virtue of being a licensed Gas Transporter (GT). Gas pipes owned by other GTs or third parties may also be present in this area but are not shown on this plan. Information with regard to such pipes should be obtained from the relevant owners. No warranties are given with regard to the accuracy of the information shown on this plan. Service pipes, valves, siphons, sub-connections etc. are not shown but their presence should be anticipated. You should be aware that a small percentage of our pipes/assets may be undergoing review and will temporarily be highlighted in yellow. If your proposed works are close to one of these pipes, you should contact the SGN Safety Admin Team on 0800 912 1722 for advice. No liability of any kind whatsoever is accepted by SGN or its agents, servants or sub-contractors for any error or omission contained herein. Safe digging practices, in accordance with HS (G)47, must be used to verify and establish the actual position of mains, pipes, services and other apparatus on site before any mechanical plant is used. It is your responsibility to ensure that plant location information is provided to all persons (whether direct labour or sub-contractors) working for you on or near gas apparatus. Information included on this plan should not be referred to beyond a period of 28 days from the date of issue.

Report damage immediately – KEEP EVERYONE AWAY FROM THE AREA
0800 111 999

Date Requested: 19/02/2025
 Job Reference: 36078720
 Site Location: 604023 140875
 Requested by: XXXXXXXXXX
 Your Scheme/Reference: 37047-2



High Pressure Gas Pipes within this vicinity

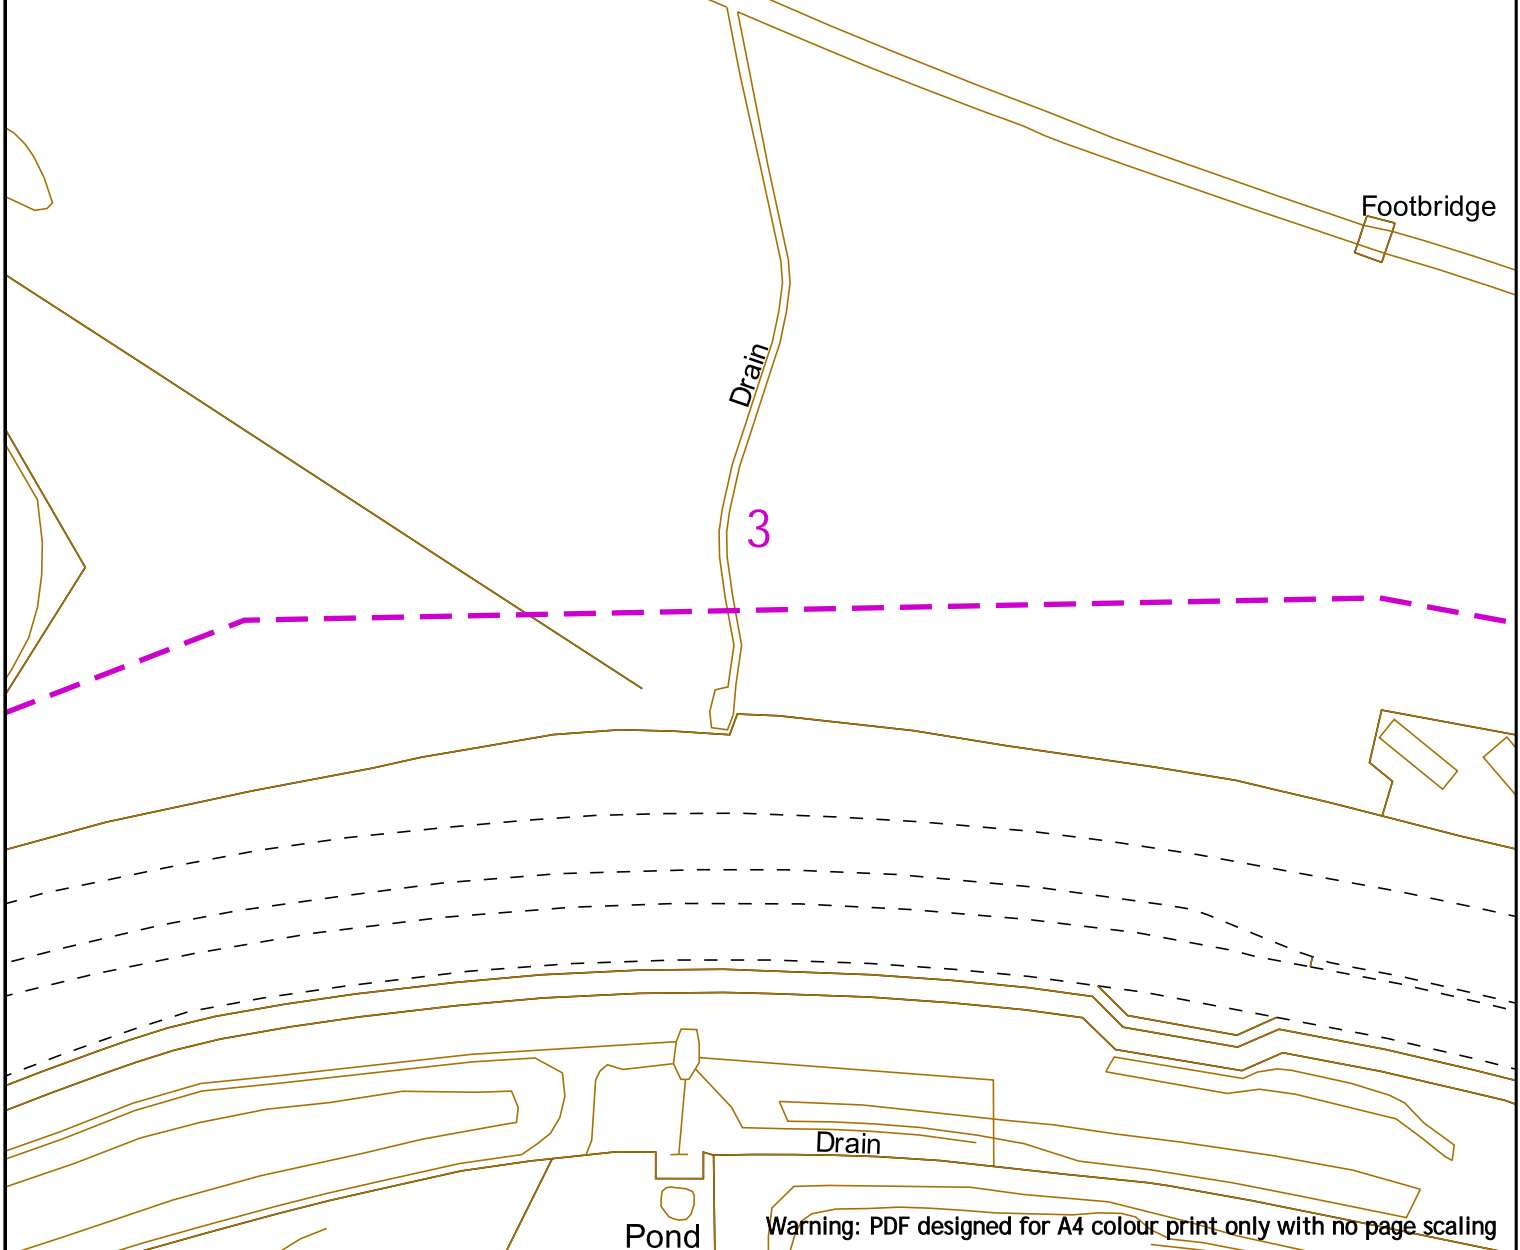

Warning: PDF designed for A4 colour print only with no page scaling



Contact Us
SGN Safety Admin Team:
 0800 912 1722
Email:
plantlocation@sgn.co.uk

Low Pressure Mains	Line:	Digsite:	Area:
Some Examples Of Plant Items			
Valve		Syphon	
Depth of Cover		Diameter Change	
		Material Change	



This information is given as a guide only and its accuracy cannot be guaranteed.




This plan shows the location of those pipes owned by Scotia Gas Networks (SGN) by virtue of being a licensed Gas Transporter (GT). Gas pipes owned by other GTs or third parties may also be present in this area but are not shown on this plan. Information with regard to such pipes should be obtained from the relevant owners. No warranties are given with regard to the accuracy of the information shown on this plan. Service pipes, valves, siphons, sub-connections etc. are not shown but their presence should be anticipated. You should be aware that a small percentage of our pipes/assets may be undergoing review and will temporarily be highlighted in yellow. If your proposed works are close to one of these pipes, you should contact the SGN Safety Admin Team on 0800 912 1722 for advice. No liability of any kind whatsoever is accepted by SGN or its agents, servants or sub-contractors for any error or omission contained herein. Safe digging practices, in accordance with HS (G)47, must be used to verify and establish the actual position of mains, pipes, services and other apparatus on site before any mechanical plant is used. It is your responsibility to ensure that plant location information is provided to all persons (whether direct labour or sub-contractors) working for you on or near gas apparatus. Information included on this plan should not be referred to beyond a period of 28 days from the date of issue.





Report damage immediately – KEEP EVERYONE AWAY FROM THE AREA
0800 111 999

This plan is reproduced from or based on the OS map by Scotia Gas Networks plc, with the sanction of the controller of HM Stationery Office. Crown Copyright Reserved. Southern Gas – 100044373 and Scotland Gas – 100044366.

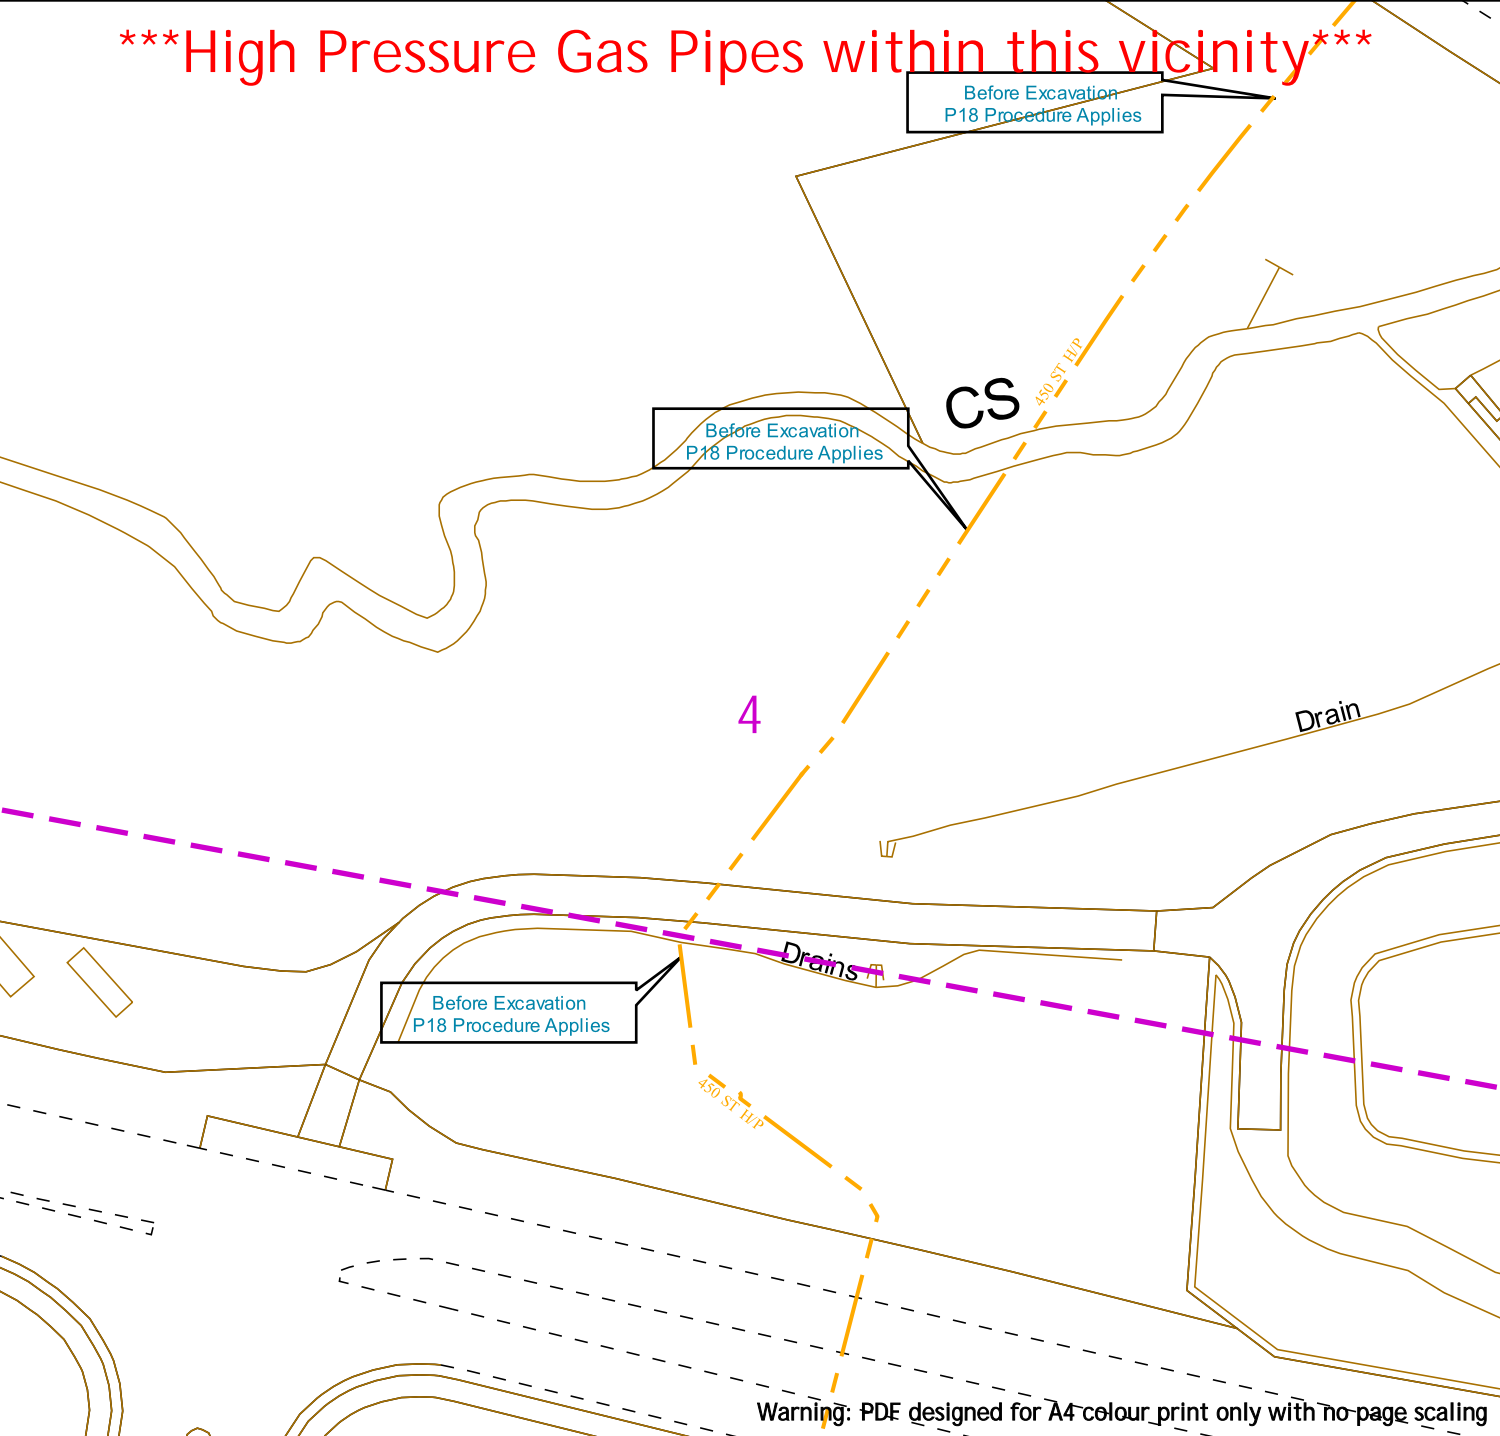Date Requested: 19/02/2025
 Job Reference: 36078720
 Site Location: 604023 140875
 Requested by:
 Your Scheme/Reference: 37047-2

Scale: 1:1000 (When plotted at A4)



 <p>Contact Us SGN Safety Admin Team: 0800 912 1722 Email: plantlocation@sgn.co.uk</p>	<table><tr><td>Low Pressure Mains</td><td></td><td>Digsite:</td><td></td></tr><tr><td>Medium Pressure Mains</td><td></td><td>Line:</td><td></td></tr><tr><td>Intermediate Pressure Mains</td><td></td><td>Area:</td><td></td></tr><tr><td>High Pressure Mains</td><td></td><td>LA's</td><td></td></tr><tr><td>H100 Hydrogen Network</td><td></td><td>GT's</td><td></td></tr><tr><td>Some Examples Of Plant Items</td><td></td><td>SSSIs</td><td></td></tr><tr><td>Valve</td><td></td><td>Syphon</td><td></td></tr><tr><td>Depth of Cover</td><td></td><td>Diameter Change</td><td></td></tr><tr><td></td><td></td><td>Material Change</td><td></td></tr></table>	Low Pressure Mains		Digsite:		Medium Pressure Mains		Line:		Intermediate Pressure Mains		Area:		High Pressure Mains		LA's		H100 Hydrogen Network		GT's		Some Examples Of Plant Items		SSSIs		Valve		Syphon		Depth of Cover		Diameter Change				Material Change		 <p>This information is given as a guide only and its accuracy cannot be guaranteed.</p> 
Low Pressure Mains		Digsite:																																				
Medium Pressure Mains		Line:																																				
Intermediate Pressure Mains		Area:																																				
High Pressure Mains		LA's																																				
H100 Hydrogen Network		GT's																																				
Some Examples Of Plant Items		SSSIs																																				
Valve		Syphon																																				
Depth of Cover		Diameter Change																																				
		Material Change																																				
<p>Date Requested: 19/02/2025 Job Reference: 36078720 Site Location: 604023 140875 Requested by:  Your Scheme/Reference: 37047-2</p>	<p>This plan shows the location of those pipes owned by Scotia Gas Networks (SGN) by virtue of being a licensed Gas Transporter (GT). Gas pipes owned by other GTs or third parties may also be present in this area but are not shown on this plan. Information with regard to such pipes should be obtained from the relevant owners. No warranties are given with regard to the accuracy of the information shown on this plan. Service pipes, valves, siphons, sub-connections etc. are not shown but their presence should be anticipated. You should be aware that a small percentage of our pipes/assets may be undergoing review and will temporarily be highlighted in yellow. If your proposed works are close to one of these pipes, you should contact the SGN Safety Admin Team on 0800 912 1722 for advice. No liability of any kind whatsoever is accepted by SGN or its agents, servants or sub-contractors for any error or omission contained herein. Safe digging practices, in accordance with HS (G)47, must be used to verify and establish the actual position of mains, pipes, services and other apparatus on site before any mechanical plant is used. It is your responsibility to ensure that plant location information is provided to all persons (whether direct labour or sub-contractors) working for you on or near gas apparatus. Information included on this plan should not be referred to beyond a period of 28 days from the date of issue.</p> <p>Report damage immediately – KEEP EVERYONE AWAY FROM THE AREA 0800 111 999</p> <p><small>This plan is reproduced from or based on the OS map by Scotia Gas Networks plc, with the sanction of the controller of the HM Stationery Office. Crown Copyright Reserved. Southern Gas – 100044373 and Scotland Gas – 100044366.</small></p>																																					

High Pressure Gas Pipes within this vicinity

Reeds

5

Balancing Pond

Def

Warning: PDF designed for A4 colour print only with no page scaling



Contact Us
SGN Safety Admin Team:
 0800 912 1722
Email:
plantlocation@sgn.co.uk

Low Pressure Mains		Digsite:	
Medium Pressure Mains		Line:	
Intermediate Pressure Mains		Area:	
High Pressure Mains		LTs	
H100 Hydrogen Network		GTs	
Some Examples Of Plant Items		SSSIs	
Valve		Syphon	
Depth of Cover		Diameter Change	
		Material Change	



This information is given as a guide only and its accuracy cannot be guaranteed.



This plan shows the location of those pipes owned by Scotia Gas Networks (SGN) by virtue of being a licensed Gas Transporter (GT). Gas pipes owned by other GTs or third parties may also be present in this area but are not shown on this plan. Information with regard to such pipes should be obtained from the relevant owners. No warranties are given with regard to the accuracy of the information shown on this plan. Service pipes, valves, siphons, sub-connections etc. are not shown but their presence should be anticipated. You should be aware that a small percentage of our pipes/assets may be undergoing review and will temporarily be highlighted in yellow. If your proposed works are close to one of these pipes, you should contact the SGN Safety Admin Team on 0800 912 1722 for advice. No liability of any kind whatsoever is accepted by SGN or its agents, servants or sub-contractors for any error or omission contained herein. Safe digging practices, in accordance with HS (G)47, must be used to verify and establish the actual position of mains, pipes, services and other apparatus on site before any mechanical plant is used. It is your responsibility to ensure that plant location information is provided to all persons (whether direct labour or sub-contractors) working for you on or near gas apparatus. Information included on this plan should not be referred to beyond a period of 28 days from the date of issue.


Report damage immediately – KEEP EVERYONE AWAY FROM THE AREA
0800 111 999

This plan is reproduced from or based on the OS map by Scotia Gas Networks plc, with the sanction of the controller of the HM Stationery Office. Crown Copyright Reserved. Southern Gas – 100044373 and Scotland Gas – 100044366.

Date Requested: 19/02/2025
 Job Reference: 36078720
 Site Location: 604023 140875
 Requested by: XXXXXXXXXX
 Your Scheme/Reference: 37047-2

Scale: 1:1000 (When plotted at A4)

Do not proceed until spoken with the asset owner. SGN have a high-risk asset in the vicinity of these proposed works. In order to evaluate the impact of your works on our asset please could you provide further details of your work to plantlocation@sgn.co.uk or [0800111999](tel:0800111999). Please note that until we receive this information and have replied back to you, no works should occur within the vicinity of the pipeline. The pipeline is of prime importance to the gas supplies of this area.

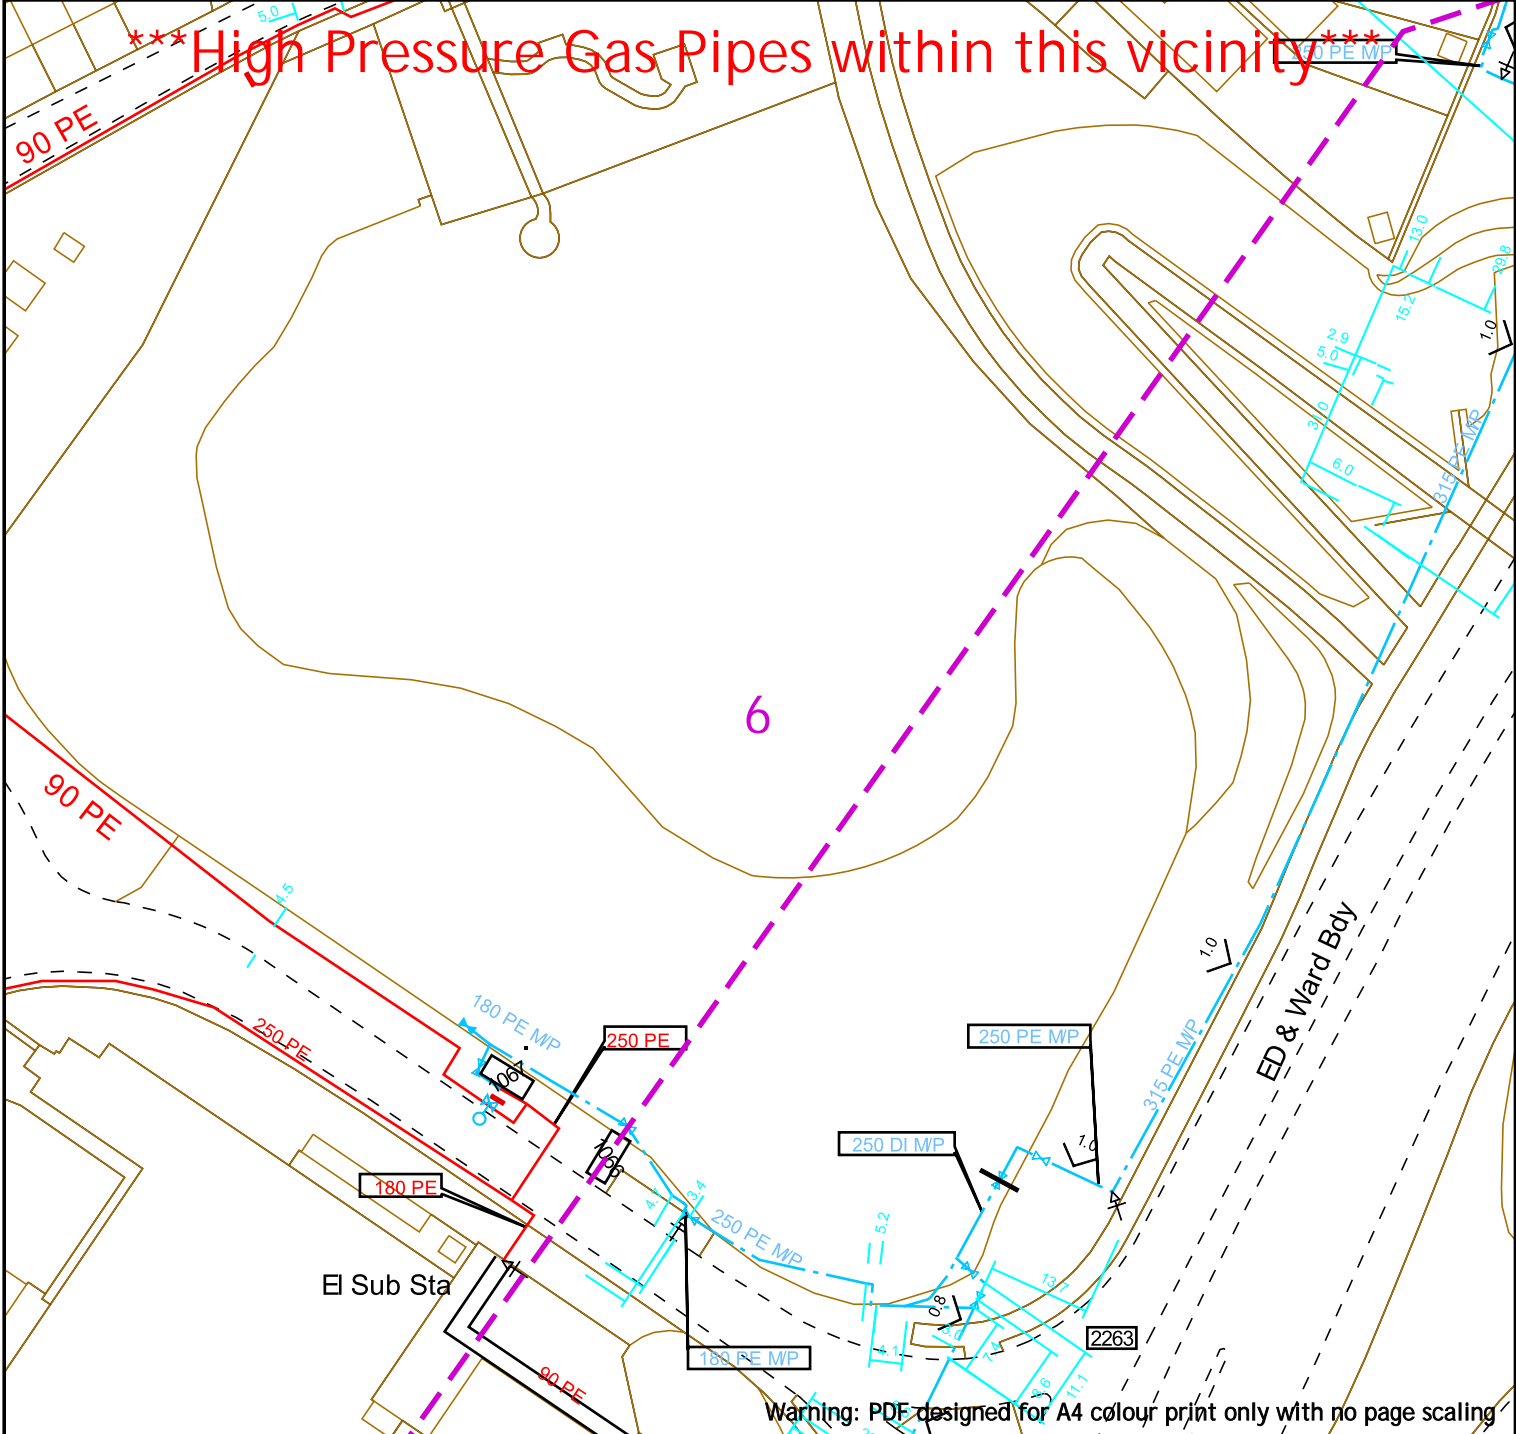

Contact Us
SGN Safety Admin Team:
0800 912 1722
Email:
plantlocation@sgn.co.uk

Low Pressure Mains	Line:	Digite:
Medium Pressure Mains	Line:	Line:
Intermediate Pressure Mains	Line:	Area:
High Pressure Mains	Line:	LA's
H100 Hydrogen Network	Line:	GT's
Some Examples Of Plant Items	SSSIs	
Valve		Depth of Cover
Syphon		Diameter Change
		Material Change



This information is given as a guide only and its accuracy cannot be guaranteed.



This plan shows the location of those pipes owned by Scotia Gas Networks (SGN) by virtue of being a licensed Gas Transporter (GT). Gas pipes owned by other GTs or third parties may also be present in this area but are not shown on this plan. Information with regard to such pipes should be obtained from the relevant owners. No warranties are given with regard to the accuracy of the information shown on this plan. Service pipes, valves, siphons, sub-connections etc. are not shown but their presence should be anticipated. You should be aware that a small percentage of our pipes/assets may be undergoing review and will temporarily be highlighted in yellow. If your proposed works are close to one of these pipes, you should contact the SGN Safety Admin Team on 0800 912 1722 for advice. No liability of any kind whatsoever is accepted by SGN or its agents, servants or sub-contractors for any error or omission contained herein. Safe digging practices, in accordance with HS (G)47, must be used to verify and establish the actual position of mains, pipes, services and other apparatus on site before any mechanical plant is used. It is your responsibility to ensure that plant location information is provided to all persons (whether direct labour or sub-contractors) working for you on or near gas apparatus. Information included on this plan should not be referred to beyond a period of 28 days from the date of issue.

Report damage immediately – KEEP EVERYONE AWAY FROM THE AREA
0800 111 999

This plan is reproduced from or based on the OS map by Scotia Gas Networks plc, with the sanction of the controller of HM Stationery Office. Crown Copyright Reserved. Southern Gas – 100044373 and Scotland Gas – 100044366.

Scale: 1:1000 (When plotted at A4)

83 of 116

High Pressure Gas Pipes within this vicinity

Def

FB

52.6m

Path

Balancing Pond


7

St Mary's Church

Warning: PDF designed for A4 colour print only with no page scaling

Warning: PDF designed for A4 colour print only with no page scaling



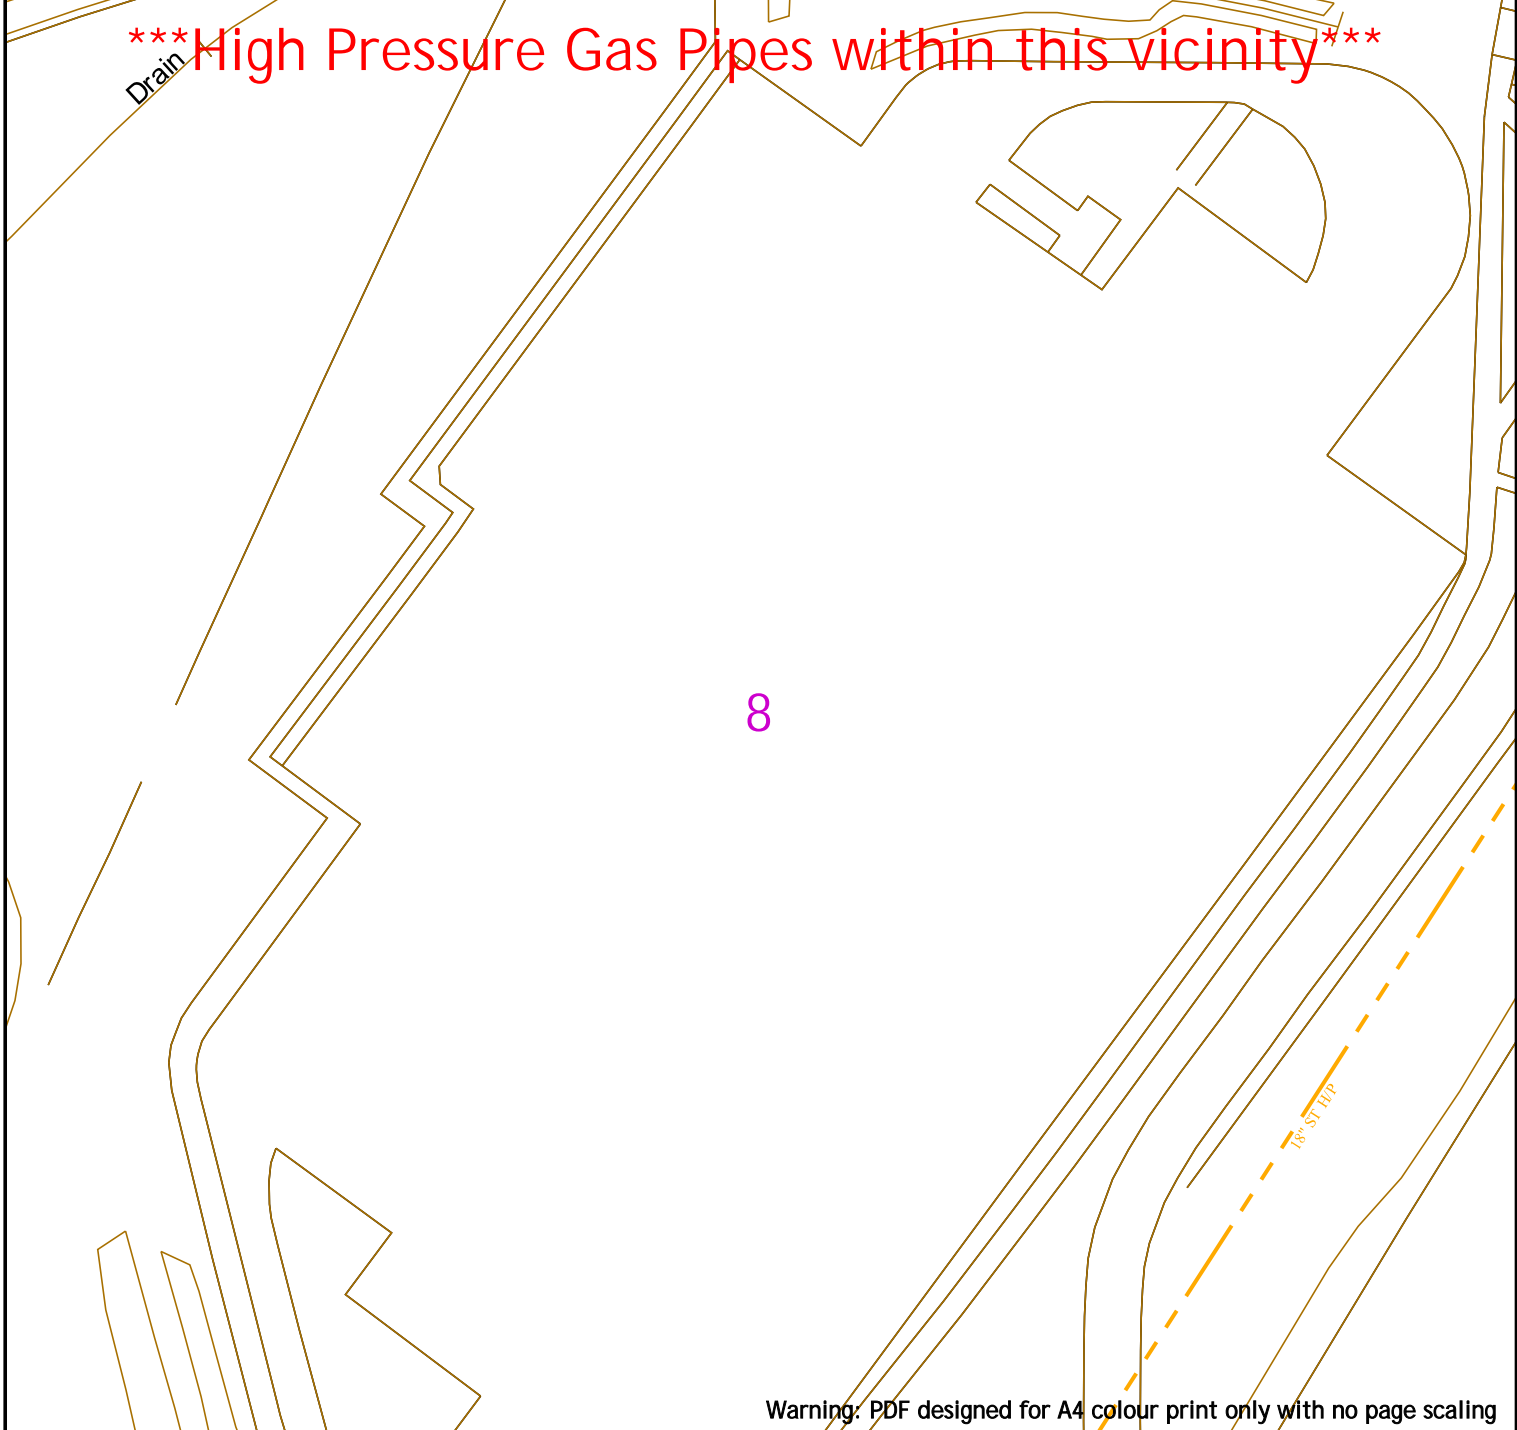

Warning: PDF designed for A4 colour print only with no page scaling



Contact Us
SGN Safety Admin Team:
 0800 912 1722
Email:
plantlocation@sgn.co.uk

Low Pressure Mains		Digsite:
Medium Pressure Mains		Line: Area:
Intermediate Pressure Mains		LA's
High Pressure Mains		GT's SSSIs
H100 Hydrogen Network		
Some Examples Of Plant Items		
Valve		Syphon
Depth of Cover		Diameter Change
		Material Change



This information is given as a guide only and its accuracy cannot be guaranteed.




This plan shows the location of those pipes owned by Scotia Gas Networks (SGN) by virtue of being a licensed Gas Transporter (GT). Gas pipes owned by other GTs or third parties may also be present in this area but are not shown on this plan. Information with regard to such pipes should be obtained from the relevant owners. No warranties are given with regard to the accuracy of the information shown on this plan. Service pipes, valves, siphons, sub-connections etc. are not shown but their presence should be anticipated. You should be aware that a small percentage of our pipes/assets may be undergoing review and will temporarily be highlighted in yellow. If your proposed works are close to one of these pipes, you should contact the SGN Safety Admin Team on 0800 912 1722 for advice. No liability of any kind whatsoever is accepted by SGN or its agents, servants or sub-contractors for any error or omission contained herein. Safe digging practices, in accordance with HS (G)47, must be used to verify and establish the actual position of mains, pipes, services and other apparatus on site before any mechanical plant is used. It is your responsibility to ensure that plant location information is provided to all persons (whether direct labour or sub-contractors) working for you on or near gas apparatus. Information included on this plan should not be referred to beyond a period of 28 days from the date of issue.

Report damage immediately – KEEP EVERYONE AWAY FROM THE AREA
0800 111 999


This plan is reproduced from or based on the OS map by Scotia Gas Networks plc, with the sanction of the controller of HM Stationery Office. Crown Copyright Reserved. Southern Gas – 100044373 and Scotland Gas – 100044366.

Date Requested: 19/02/2025
 Job Reference: 36078720
 Site Location: 604023 140875
 Requested by:
 Your Scheme/Reference: 37047-2

Scale: 1:1000 (When plotted at A4)

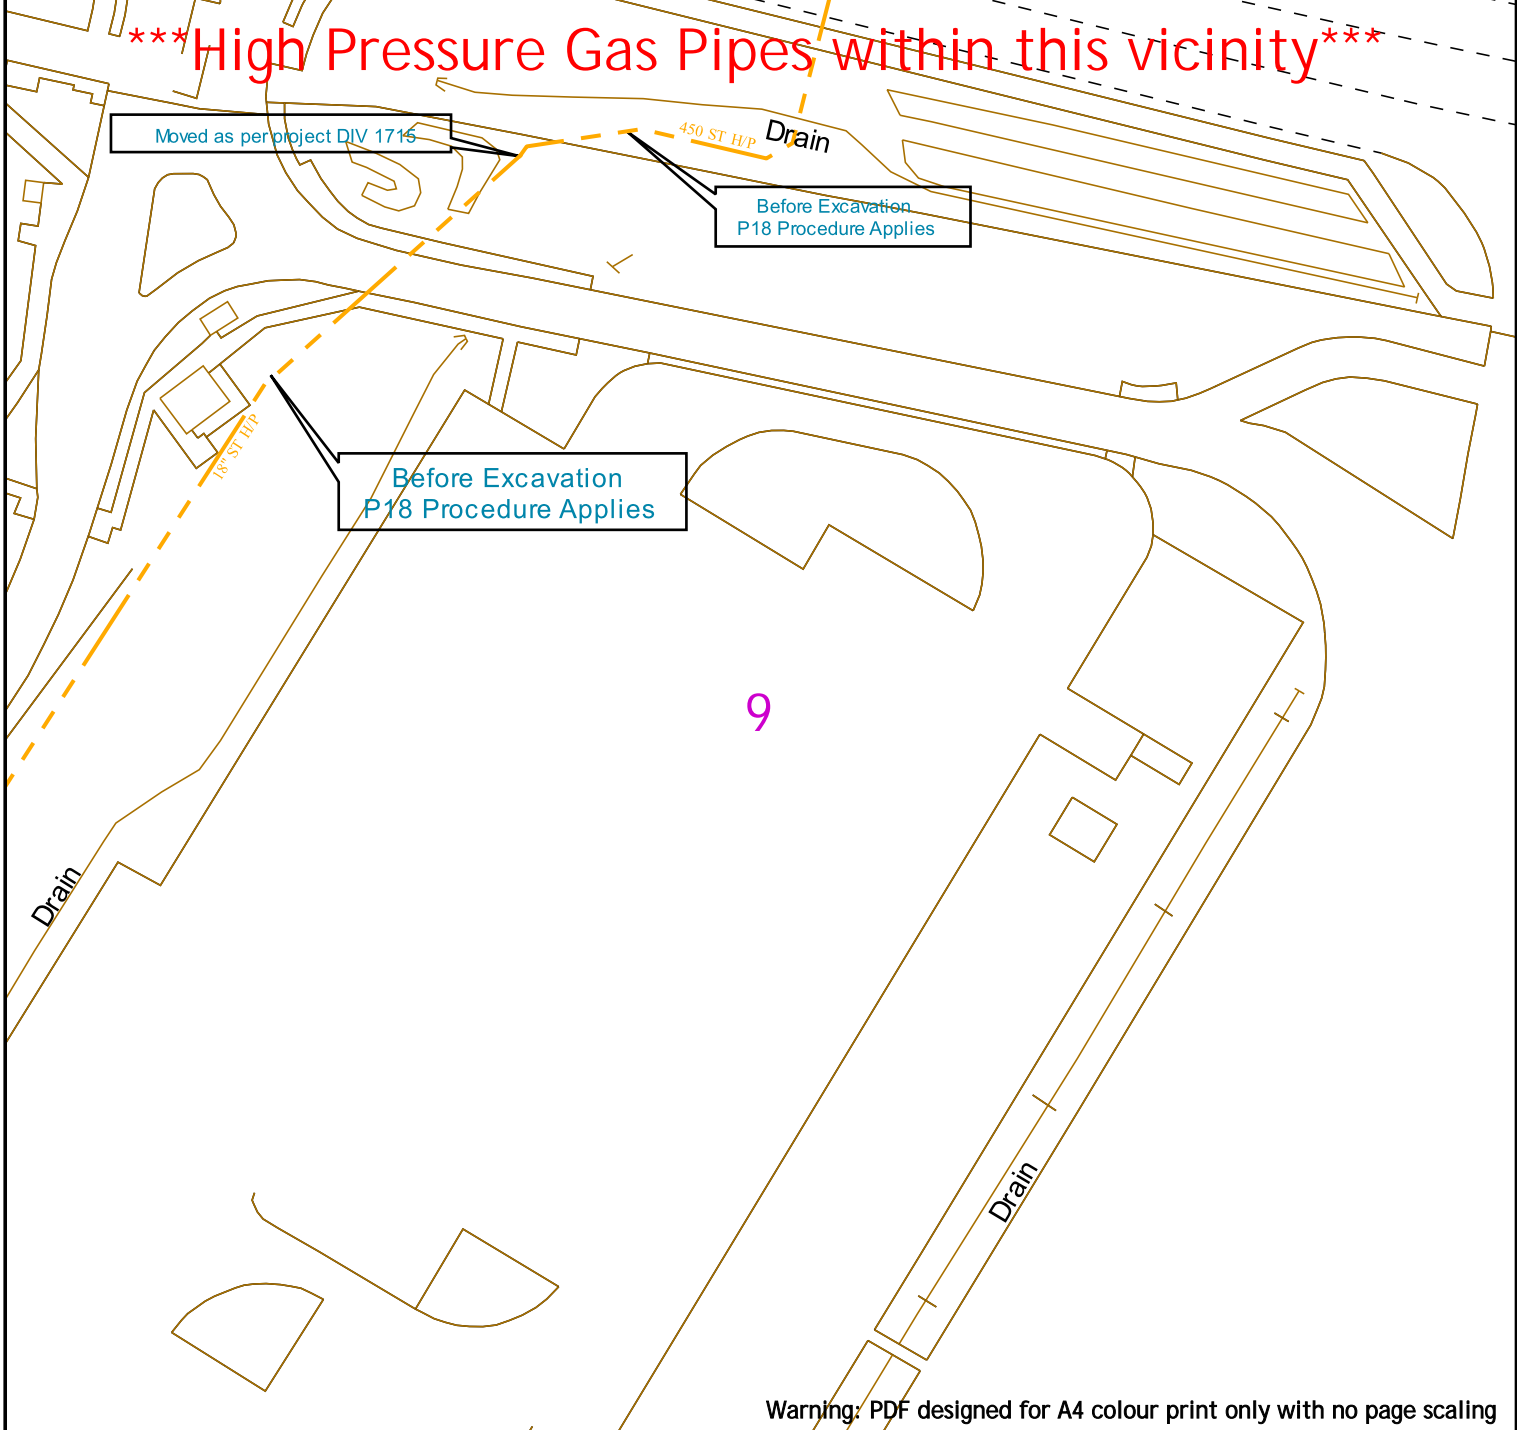

Contact Us
SGN Safety Admin Team:
0800 912 1722
Email:
plantlocation@sgn.co.uk

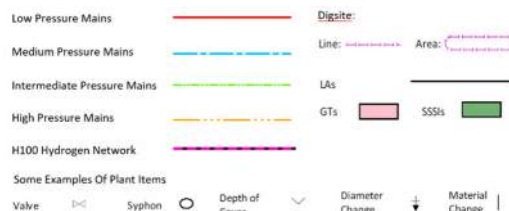

This information is given as a guide only and its accuracy cannot be guaranteed.



Date Requested: 19/02/2025
Job Reference: 36078720
Site Location: 604023 140875
Requested by: XXXXXXXXXX
Your Scheme/Reference: 37047-2


This plan shows the location of those pipes owned by Scotia Gas Networks (SGN) by virtue of being a licensed Gas Transporter (GT). Gas pipes owned by other GTs or third parties may also be present in this area but are not shown on this plan. Information with regard to such pipes should be obtained from the relevant owners. No warranties are given with regard to the accuracy of the information shown on this plan. Service pipes, valves, siphons, sub-connections etc. are not shown but their presence should be anticipated. You should be aware that a small percentage of our pipes/assets may be undergoing review and will temporarily be highlighted in yellow. If your proposed works are close to one of these pipes, you should contact the SGN Safety Admin Team on 0800 912 1722 for advice. No liability of any kind whatsoever is accepted by SGN or its agents, servants or sub-contractors for any error or omission contained herein. Safe digging practices, in accordance with HS (G)47, must be used to verify and establish the actual position of mains, pipes, services and other apparatus on site before any mechanical plant is used. It is your responsibility to ensure that plant location information is provided to all persons (whether direct labour or sub-contractors) working for you on or near gas apparatus. Information included on this plan should not be referred to beyond a period of 28 days from the date of issue.

Report damage immediately – KEEP EVERYONE AWAY FROM THE AREA
0800 111 999

Scale: 1:1000 (When plotted at A4)

This plan is reproduced from or based on the OS map by Scotia Gas Networks plc, with the sanction of the controller of HM Stationery Office. Crown Copyright Reserved. Southern Gas – 100044373 and Scotland Gas – 100044366.


High Pressure Gas Pipes within this vicinity

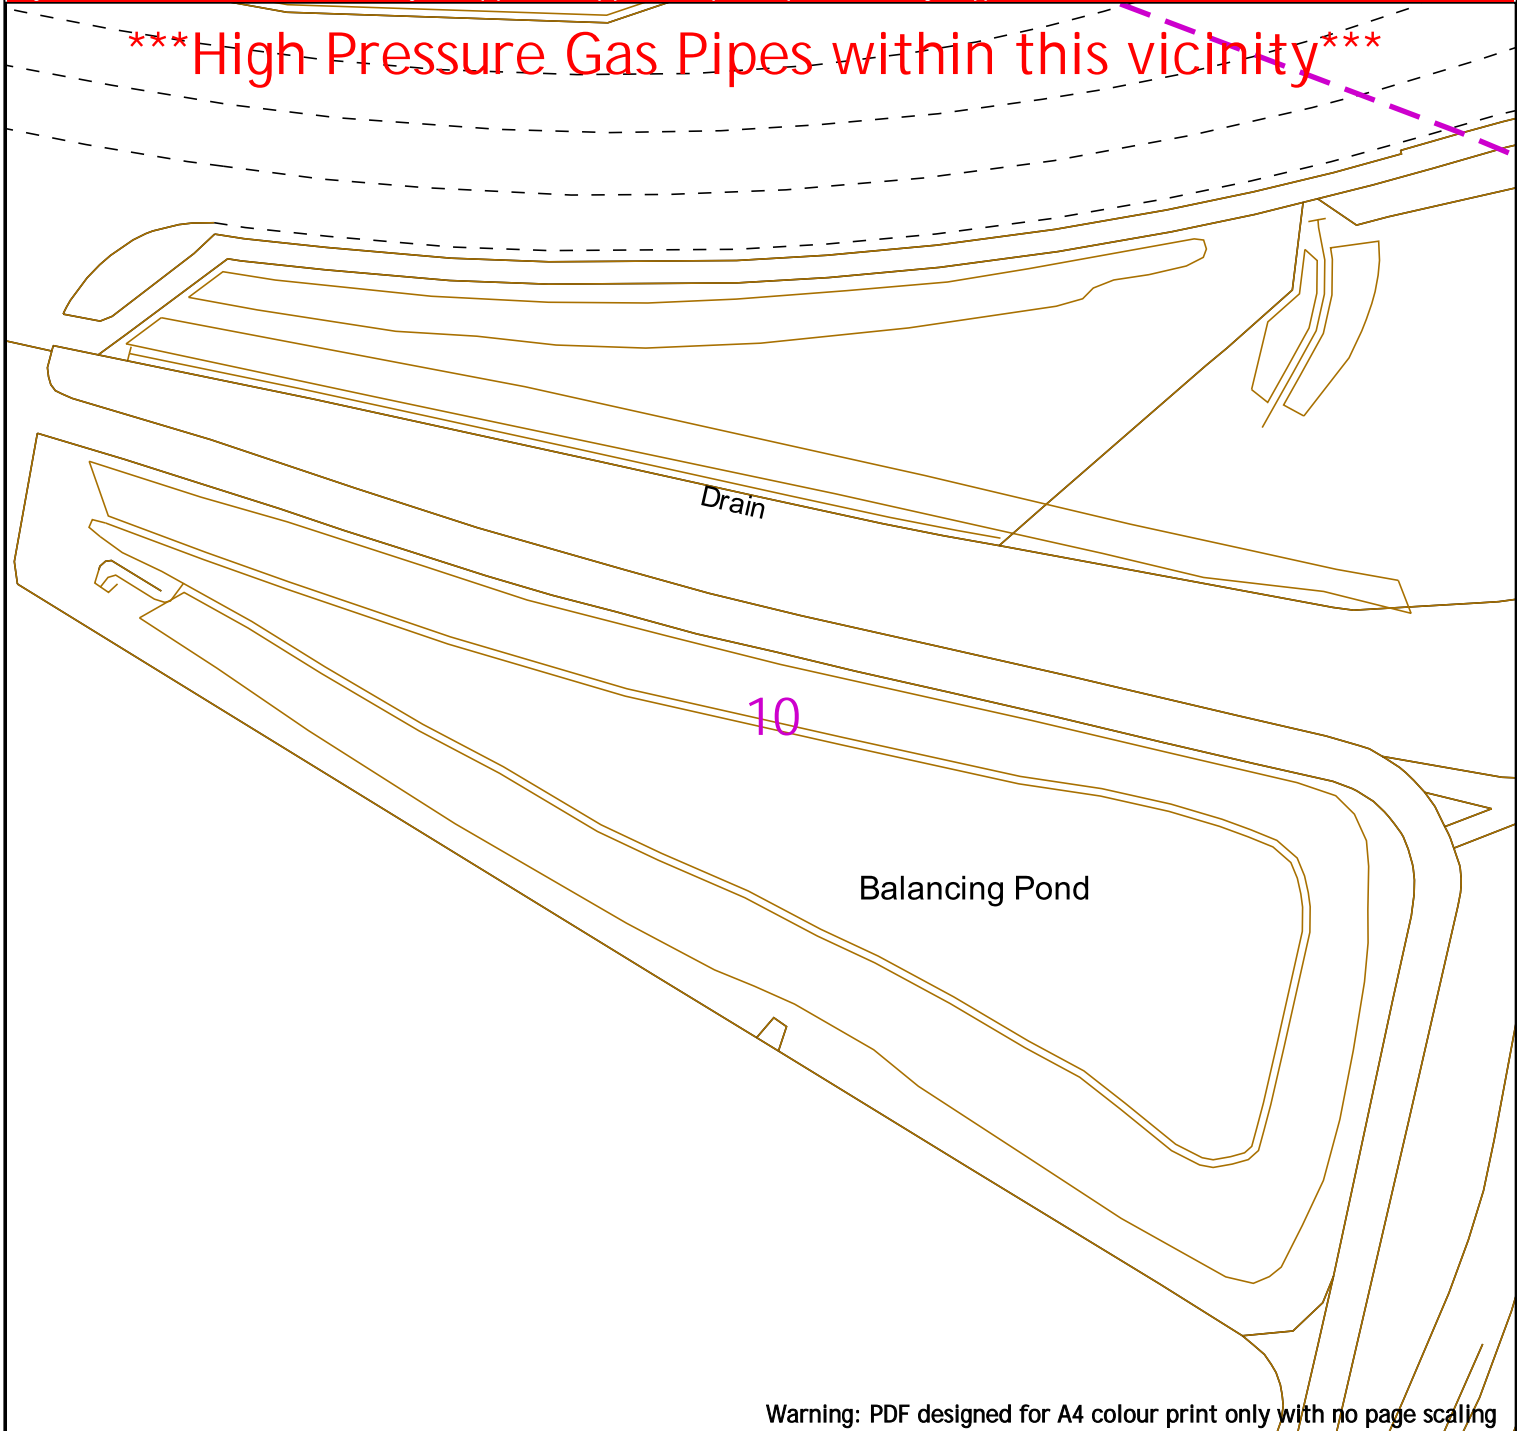

Warning: PDF designed for A4 colour print only with no page scaling



Contact Us
SGN Safety Admin Team:
 0800 912 1722
Email:
plantlocation@sgn.co.uk

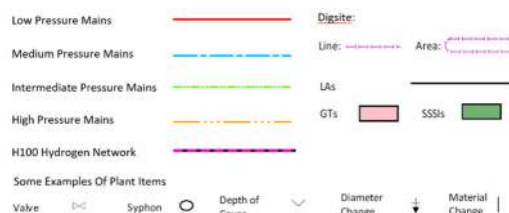

This information is given as a guide only and its accuracy cannot be guaranteed.




This plan shows the location of those pipes owned by Scotia Gas Networks (SGN) by virtue of being a licensed Gas Transporter (GT). Gas pipes owned by other GTs or third parties may also be present in this area but are not shown on this plan. Information with regard to such pipes should be obtained from the relevant owners. No warranties are given with regard to the accuracy of the information shown on this plan. Service pipes, valves, siphons, sub-connections etc. are not shown but their presence should be anticipated. You should be aware that a small percentage of our pipes/assets may be undergoing review and will temporarily be highlighted in yellow. If your proposed works are close to one of these pipes, you should contact the SGN Safety Admin Team on 0800 912 1722 for advice. No liability of any kind whatsoever is accepted by SGN or its agents, servants or sub-contractors for any error or omission contained herein. Safe digging practices, in accordance with HS (G)47, must be used to verify and establish the actual position of mains, pipes, services and other apparatus on site before any mechanical plant is used. It is your responsibility to ensure that plant location information is provided to all persons (whether direct labour or sub-contractors) working for you on or near gas apparatus. Information included on this plan should not be referred to beyond a period of 28 days from the date of issue.

Report damage immediately – KEEP EVERYONE AWAY FROM THE AREA
0800 111 999

Date Requested: 19/02/2025
 Job Reference: 36078720
 Site Location: 604023 140875
 Requested by:
 Your Scheme/Reference: 37047-2

Scale: 1:1000 (When plotted at A4)

High Pressure Gas Pipes within this vicinity

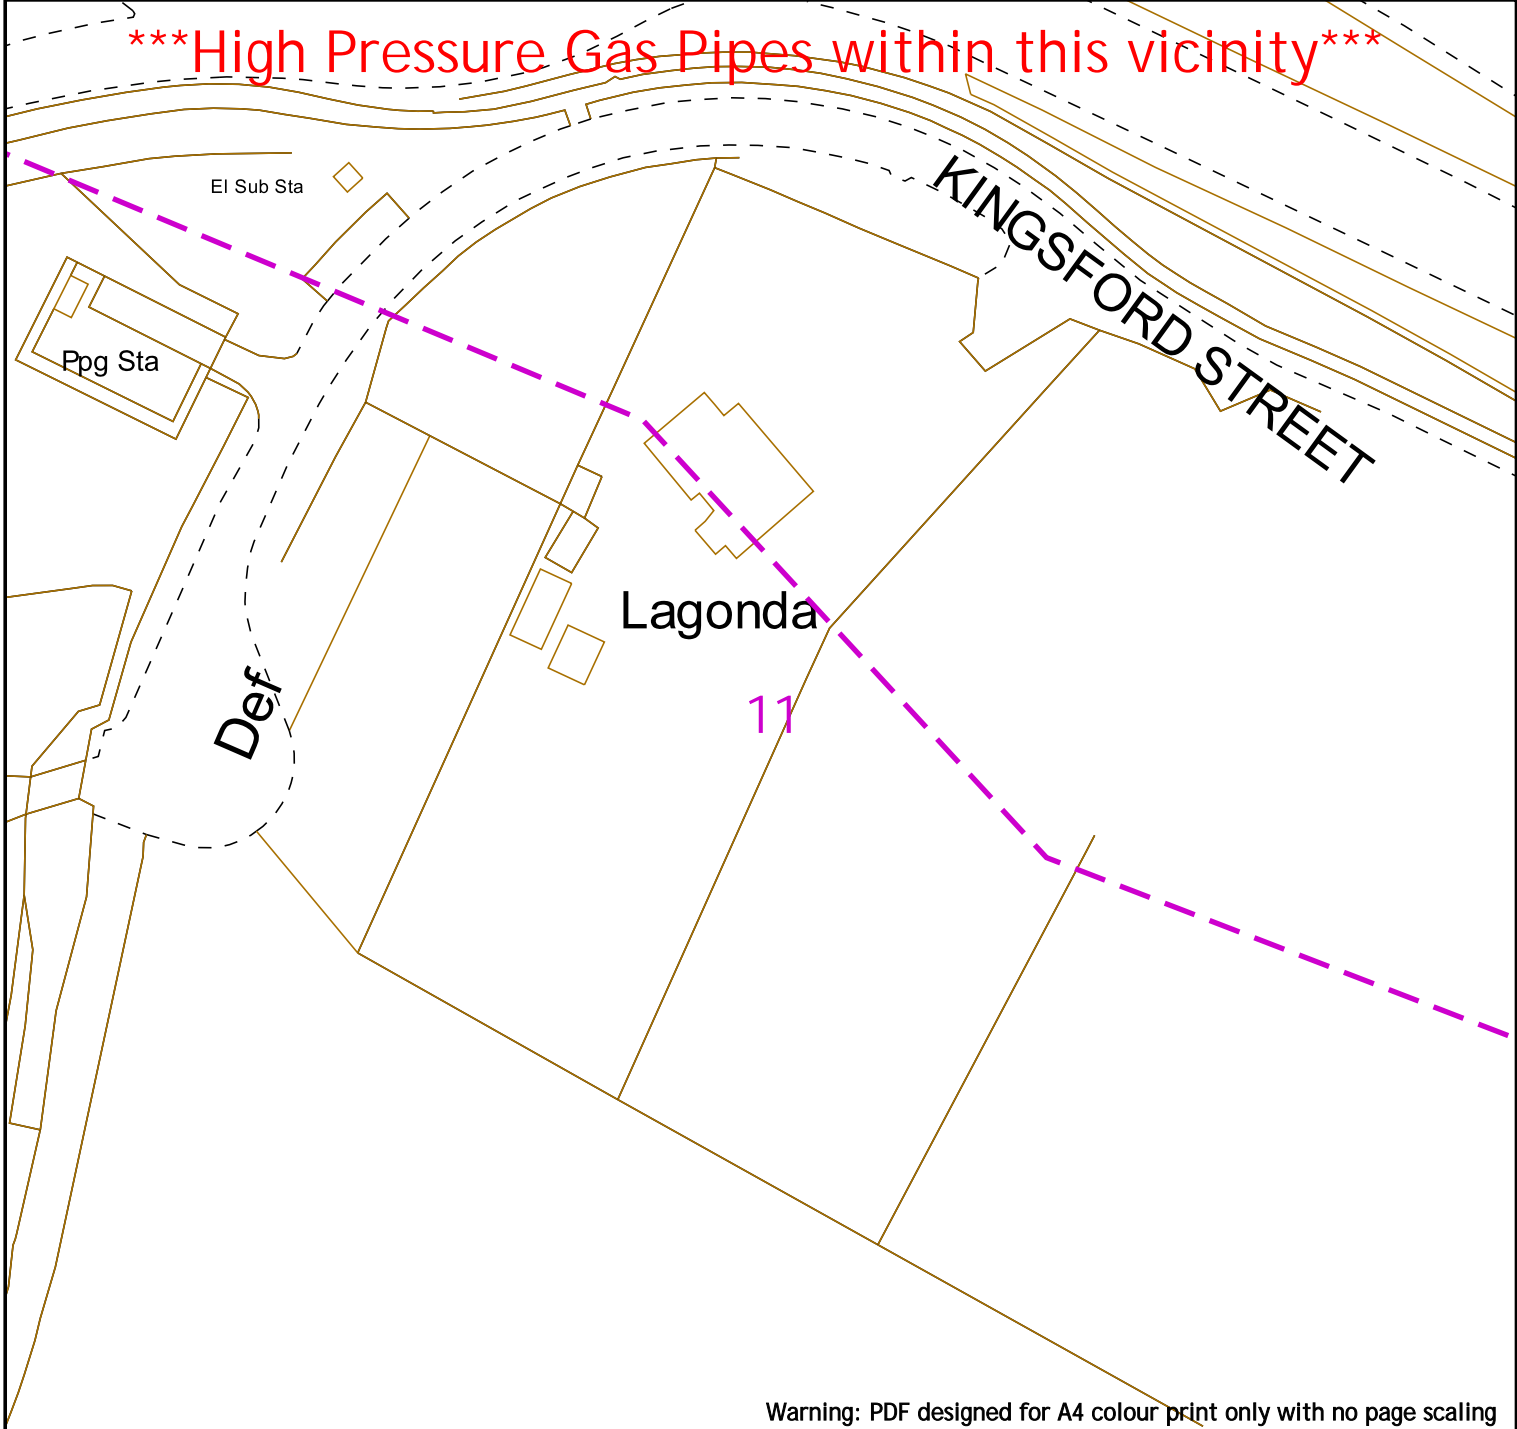

Warning: PDF designed for A4 colour print only with no page scaling



Contact Us
SGN Safety Admin Team:
 0800 912 1722
Email:
plantlocation@sgn.co.uk

Low Pressure Mains		Digsite:	
Medium Pressure Mains		Line:	
Intermediate Pressure Mains		Area:	
High Pressure Mains		LAs	
H100 Hydrogen Network		GTs	
Some Examples Of Plant Items		SSSIs	
Valve		Syphon	
Depth of Cover		Diameter Change	
		Material Change	



This information is given as a guide only and its accuracy cannot be guaranteed.



This plan shows the location of those pipes owned by Scotia Gas Networks (SGN) by virtue of being a licensed Gas Transporter (GT). Gas pipes owned by other GTs or third parties may also be present in this area but are not shown on this plan. Information with regard to such pipes should be obtained from the relevant owners. No warranties are given with regard to the accuracy of the information shown on this plan. Service pipes, valves, siphons, sub-connections etc. are not shown but their presence should be anticipated. You should be aware that a small percentage of our pipes/assets may be undergoing review and will temporarily be highlighted in yellow. If your proposed works are close to one of these pipes, you should contact the SGN Safety Admin Team on 0800 912 1722 for advice. No liability of any kind whatsoever is accepted by SGN or its agents, servants or sub-contractors for any error or omission contained herein. Safe digging practices, in accordance with HS (G)47, must be used to verify and establish the actual position of mains, pipes, services and other apparatus on site before any mechanical plant is used. It is your responsibility to ensure that plant location information is provided to all persons (whether direct labour or sub-contractors) working for you on or near gas apparatus. Information included on this plan should not be referred to beyond a period of 28 days from the date of issue.

Report damage immediately – KEEP EVERYONE AWAY FROM THE AREA
0800 111 999

This plan is reproduced from or based on the OS map by Scotia Gas Networks plc, with the sanction of the controller of the HM Stationery Office. Crown Copyright Reserved. Southern Gas – 100044373 and Scotland Gas – 100044366.

Date Requested: 19/02/2025
 Job Reference: 36078720
 Site Location: 604023 140875
 Requested by:
 Your Scheme/Reference: 37047-2

Scale: 1:1000 (When plotted at A4)

High Pressure Gas Pipes within this vicinity


M 20

12

Warning: PDF designed for A4 colour print only with no page scaling



Contact Us
SGN Safety Admin Team:
0800 912 1722
Email:
plantlocation@sgn.co.uk

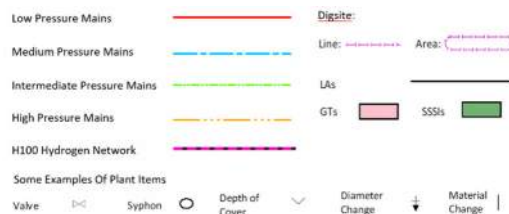

This information is given as a guide only and its accuracy cannot be guaranteed.



This plan shows the location of those pipes owned by Scotia Gas Networks (SGN) by virtue of being a licensed Gas Transporter (GT). Gas pipes owned by other GTs or third parties may also be present in this area but are not shown on this plan. Information with regard to such pipes should be obtained from the relevant owners. No warranties are given with regard to the accuracy of the information shown on this plan. Service pipes, valves, siphons, sub-connections etc. are not shown but their presence should be anticipated. You should be aware that a small percentage of our pipes/assets may be undergoing review and will temporarily be highlighted in yellow. If your proposed works are close to one of these pipes, you should contact the SGN Safety Admin Team on 0800 912 1722 for advice. No liability of any kind whatsoever is accepted by SGN or its agents, servants or sub-contractors for any error or omission contained herein. Safe digging practices, in accordance with HS (G)47, must be used to verify and establish the actual position of mains, pipes, services and other apparatus on site before any mechanical plant is used. It is your responsibility to ensure that plant location information is provided to all persons (whether direct labour or sub-contractors) working for you on or near gas apparatus. Information included on this plan should not be referred to beyond a period of 28 days from the date of issue.

Report damage immediately – KEEP EVERYONE AWAY FROM THE AREA
0800 111 999

This plan is reproduced from or based on the OS map by Scotia Gas Networks plc, with the sanction of the controller of the HM Stationery Office. Crown Copyright Reserved. Southern Gas – 100044373 and Scotland Gas – 100044366.

Date Requested: 19/02/2025
Job Reference: 36078720
Site Location: 604023 140875
Requested by: XXXXXXXXXX
Your Scheme/Reference: 37047-2

Scale: 1:1000 (When plotted at A4)


The map displays a complex network of gas pipes overlaid on a street map. Key features include:

- Pipe Networks:**
 - A red solid line labeled "125 PE" runs diagonally across the upper left.
 - Cyan dashed lines labeled "63 PE MP" form a loop at the bottom left.
 - A purple dashed line runs along the right edge of the map.
- Infrastructure:**
 - "Sub Sta" labels are located near the top center and bottom center.
 - An "FS" (Fire Station) label is on the left side.
 - "Ashford Retail Park" is labeled in large black text on the right.
- Other Labels:**
 - A purple number "13" is in the center.
 - A box containing the number "624010189" points to a specific location on the cyan pipe network.
 - Various numerical values (e.g., 17.5, 13.5, 38.0, 8.0, 15.0) are placed along the pipe segments, likely representing distances or pressures.
- Warning:** A note at the bottom right states: "Warning: PDF designed for A4 colour print only with no page scaling".



Do not proceed until spoken with the asset owner. SGN have a high-risk asset in the vicinity of these proposed works. In order to evaluate the impact of your works on our asset please could you provide further details of your work to plantlocation@sgn.co.uk or 800111999. Please note that until we receive this information and have replied back to you, no works should occur within the vicinity of the pipeline. The pipeline is of prime importance to the gas supplies of this area.

High Pressure Gas Pipes within this vicinity

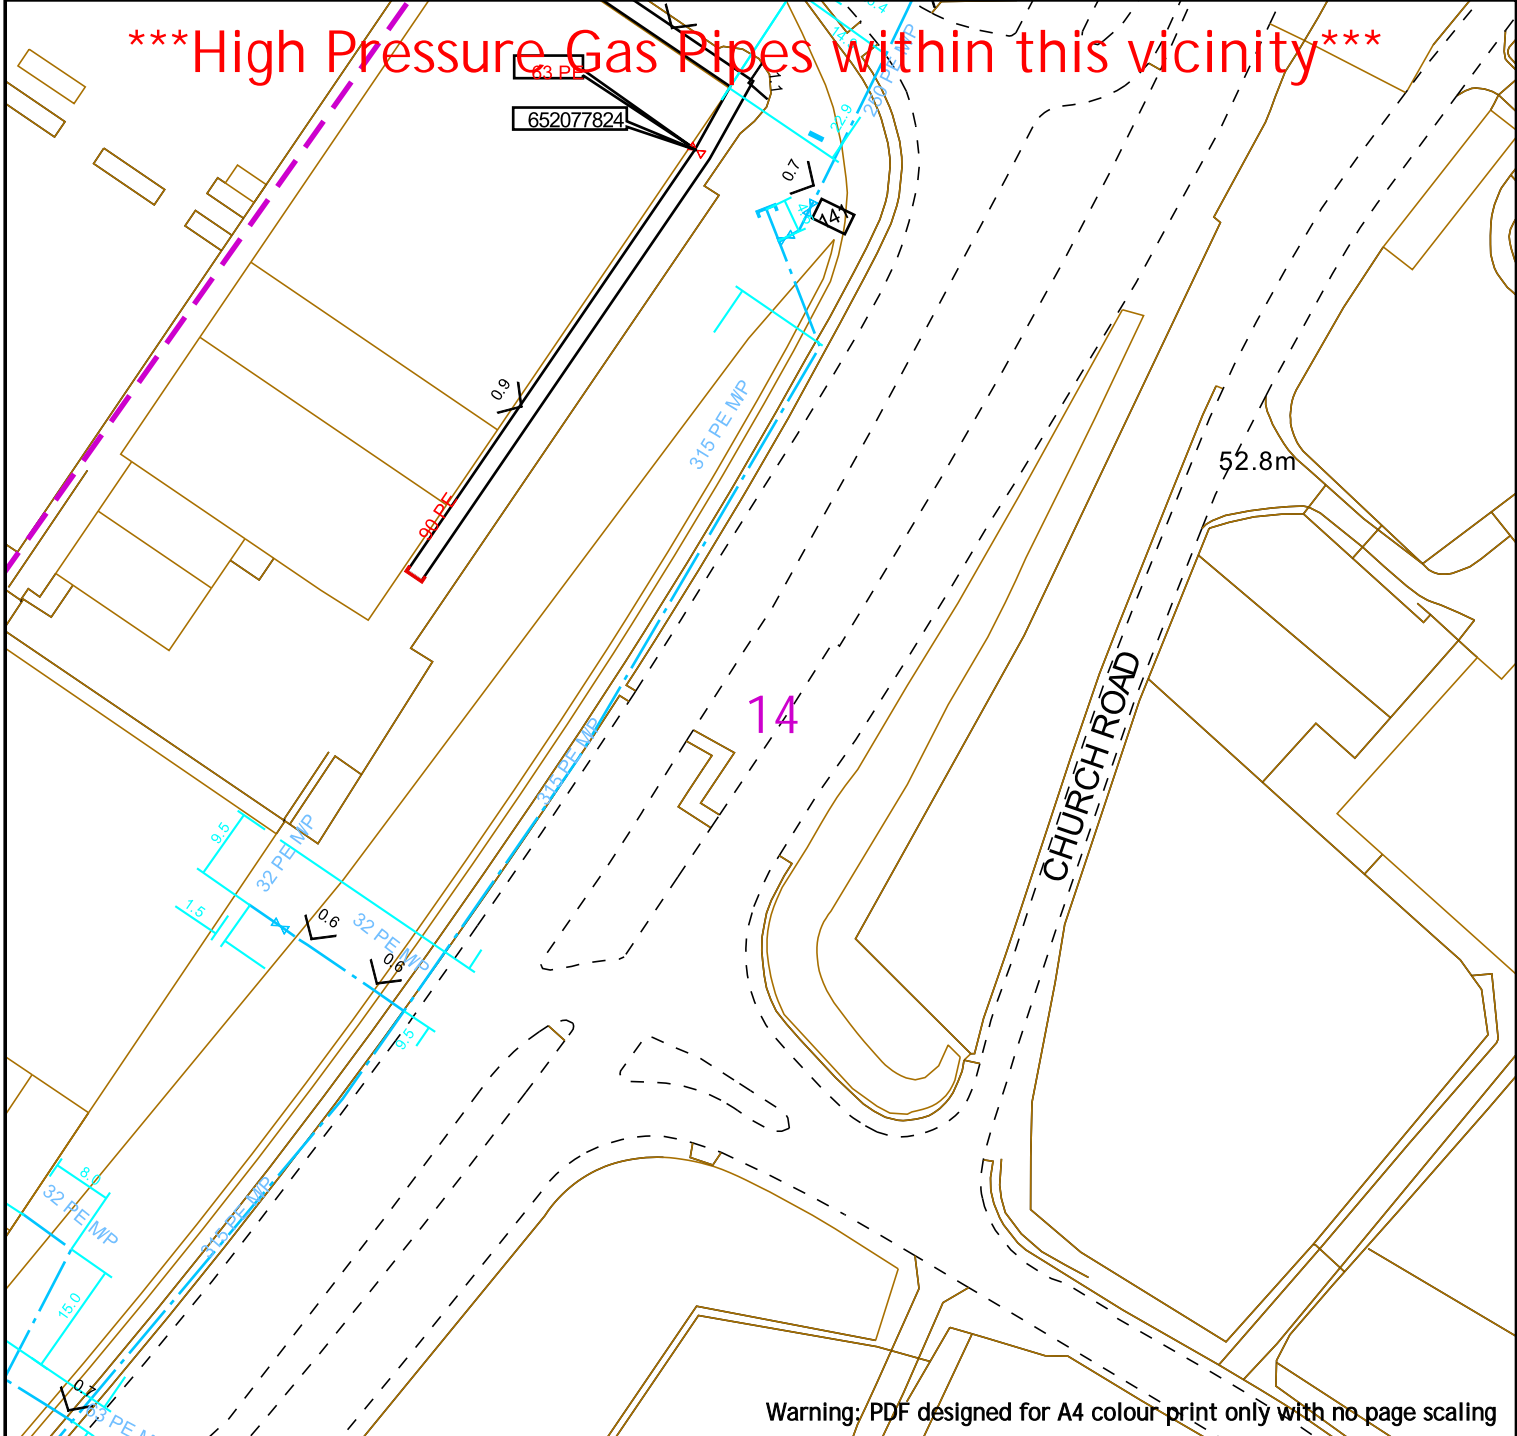

Warning: PDF designed for A4 colour print only with no page scaling



Contact Us
SGN Safety Admin Team:
 0800 912 1722
Email:
plantlocation@sgn.co.uk

Low Pressure Mains	—	Digsite:	—
Medium Pressure Mains	—	Line:	—
Intermediate Pressure Mains	—	LA:	—
High Pressure Mains	—	GTs:	—
H100 Hydrogen Network	—	SSSIs:	—
Some Examples Of Plant Items			
Valve	—	Syphon	—
Depth of Cover	—	Diameter Change	—
	—	Material Change	—



This information is given as a guide only and its accuracy cannot be guaranteed.



This plan shows the location of those pipes owned by Scotia Gas Networks (SGN) by virtue of being a licensed Gas Transporter (GT). Gas pipes owned by other GTs or third parties may also be present in this area but are not shown on this plan. Information with regard to such pipes should be obtained from the relevant owners. No warranties are given with regard to the accuracy of the information shown on this plan. Service pipes, valves, siphons, sub-connections etc. are not shown but their presence should be anticipated. You should be aware that a small percentage of our pipes/assets may be undergoing review and will temporarily be highlighted in yellow. If your proposed works are close to one of these pipes, you should contact the SGN Safety Admin Team on 0800 912 1722 for advice. No liability of any kind whatsoever is accepted by SGN or its agents, servants or sub-contractors for any error or omission contained herein. Safe digging practices, in accordance with HS (G)47, must be used to verify and establish the actual position of mains, pipes, services and other apparatus on site before any mechanical plant is used. It is your responsibility to ensure that plant location information is provided to all persons (whether direct labour or sub-contractors) working for you on or near gas apparatus. Information included on this plan should not be referred to beyond a period of 28 days from the date of issue.

Report damage immediately – KEEP EVERYONE AWAY FROM THE AREA
0800 111 999

This plan is reproduced from or based on the OS map by Scotia Gas Networks plc, with the sanction of the controller of HM Stationery Office. Crown Copyright Reserved. Southern Gas – 100044373 and Scotland Gas – 100044366.

Date Requested: 19/02/2025
 Job Reference: 36078720
 Site Location: 604023 140875
 Requested by: XXXXXXXXXX
 Your Scheme/Reference: 37047-2

Scale: 1:1000 (When plotted at A4)

High Pressure Gas Pipes within this vicinity

Court Lodge

Track


15

Sevington

Warning: PDF designed for A4 colour print only with no page scaling



Contact Us
SGN Safety Admin Team:
 0800 912 1722
Email:
plantlocation@sgn.co.uk

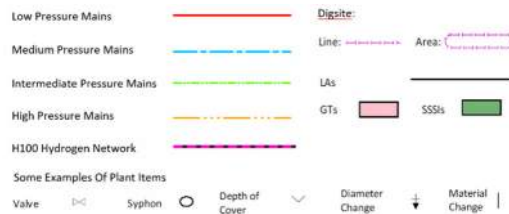

This information is given as a guide only and its accuracy cannot be guaranteed.




This plan shows the location of those pipes owned by Scotia Gas Networks (SGN) by virtue of being a licensed Gas Transporter (GT). Gas pipes owned by other GTs or third parties may also be present in this area but are not shown on this plan. Information with regard to such pipes should be obtained from the relevant owners. No warranties are given with regard to the accuracy of the information shown on this plan. Service pipes, valves, siphons, sub-connections etc. are not shown but their presence should be anticipated. You should be aware that a small percentage of our pipes/assets may be undergoing review and will temporarily be highlighted in yellow. If your proposed works are close to one of these pipes, you should contact the SGN Safety Admin Team on 0800 912 1722 for advice. No liability of any kind whatsoever is accepted by SGN or its agents, servants or sub-contractors for any error or omission contained herein. Safe digging practices, in accordance with HS (G)47, must be used to verify and establish the actual position of mains, pipes, services and other apparatus on site before any mechanical plant is used. It is your responsibility to ensure that plant location information is provided to all persons (whether direct labour or sub-contractors) working for you on or near gas apparatus. Information included on this plan should not be referred to beyond a period of 28 days from the date of issue.


Report damage immediately – KEEP EVERYONE AWAY FROM THE AREA
0800 111 999

This plan is reproduced from or based on the OS map by Scotia Gas Networks plc, with the sanction of the controller of the HM Stationery Office. Crown Copyright Reserved. Southern Gas – 100044373 and Scotland Gas – 100044366.

Date Requested: 19/02/2025
 Job Reference: 36078720
 Site Location: 604023 140875
 Requested by: XXXXXXXXXX
 Your Scheme/Reference: 37047-2

Scale: 1:1000 (When plotted at A4)

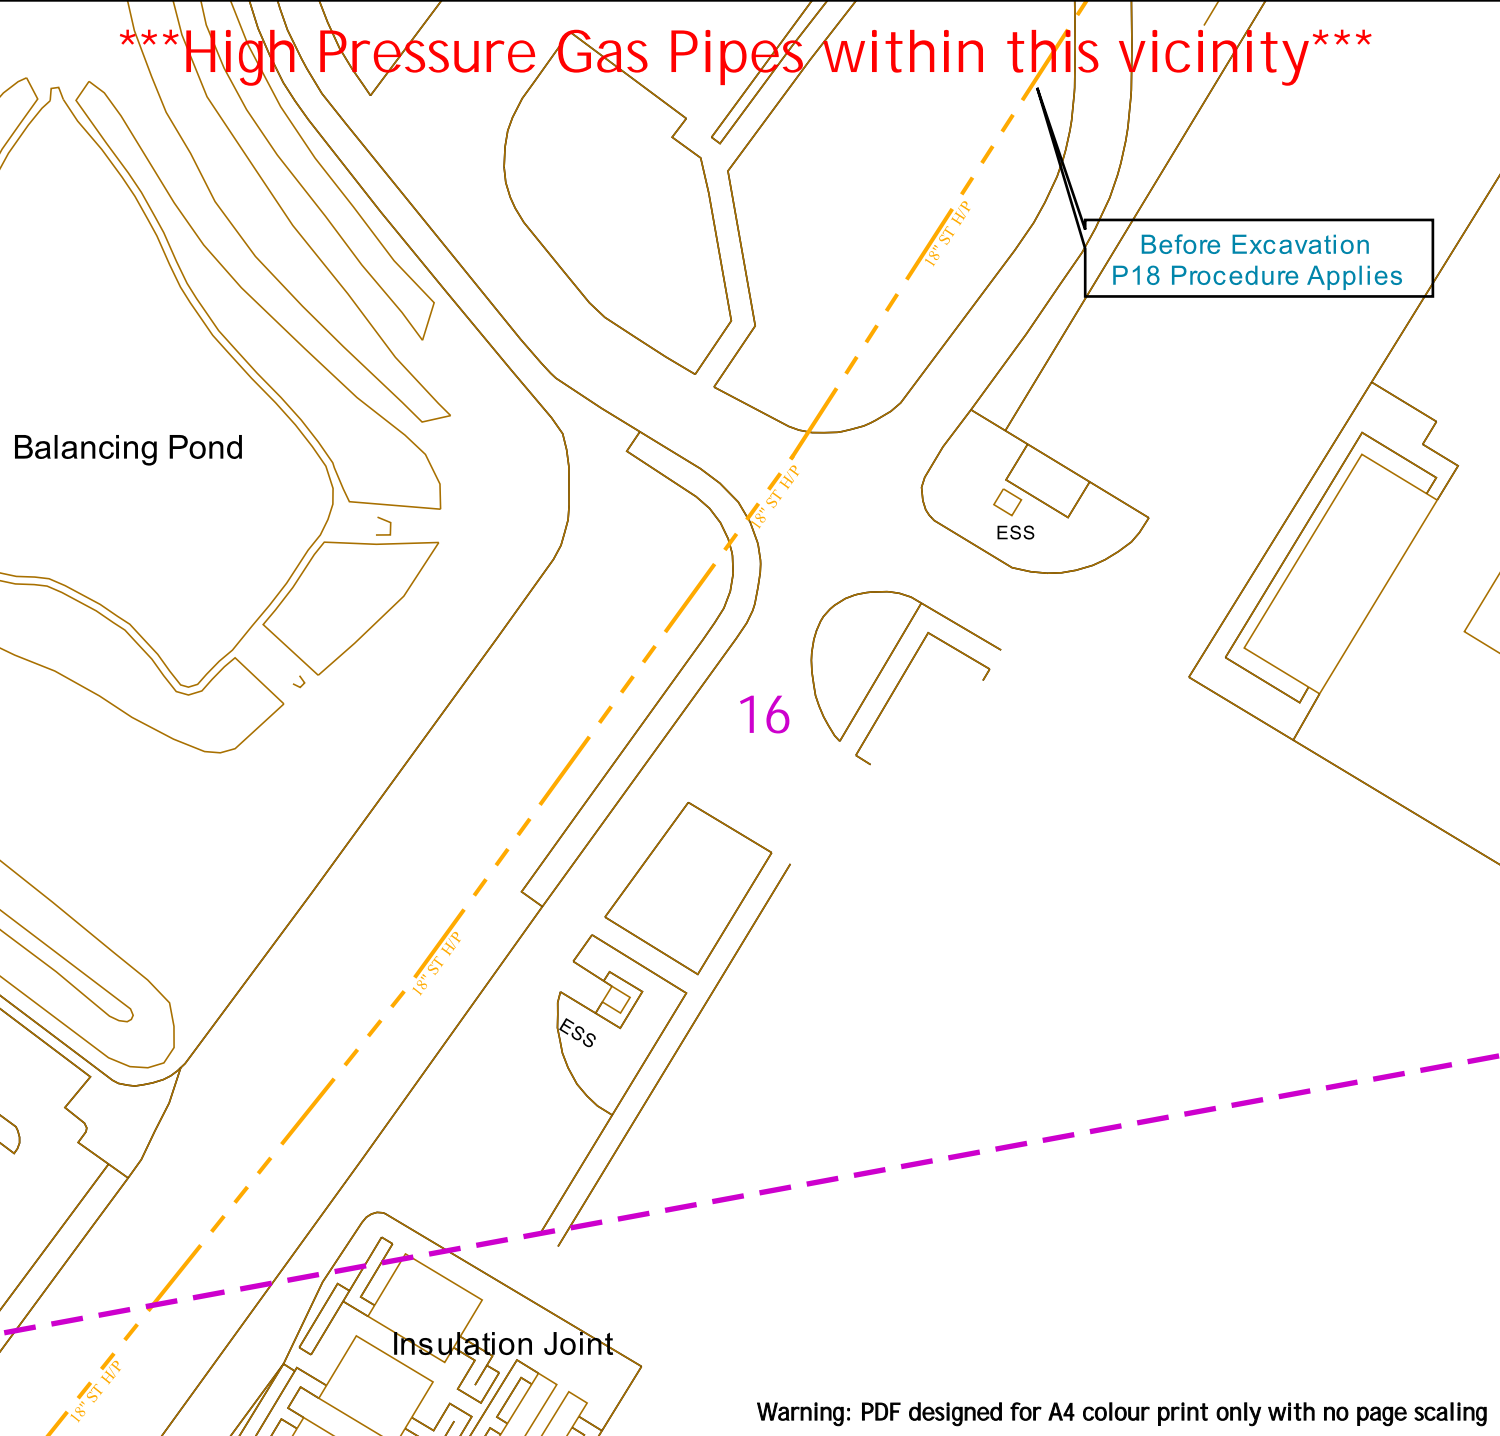




Contact Us
SGN Safety Admin Team:
0800 912 1722
Email:
plantlocation@sgn.co.uk


Low Pressure Mains
Medium Pressure Mains
Intermediate Pressure Mains
High Pressure Mains
H100 Hydrogen Network

Some Examples Of Plant Items
Valve
Siphon
Depth of Cover
Diameter Change
Material Change

Digsite:
Line:
Area:
LAs
GTs
SSSIs



This information is given as a guide only and its accuracy cannot be guaranteed.



Date Requested: 19/02/2025
Job Reference: 36078720
Site Location: 604023 140875
Requested by: XXXXXXXXXX
Your Scheme/Reference: 37047-2

This plan shows the location of those pipes owned by Scotia Gas Networks (SGN) by virtue of being a licensed Gas Transporter (GT). Gas pipes owned by other GTs or third parties may also be present in this area but are not shown on this plan. Information with regard to such pipes should be obtained from the relevant owners. No warranties are given with regard to the accuracy of the information shown on this plan. Service pipes, valves, siphons, sub-connections etc. are not shown but their presence should be anticipated. You should be aware that a small percentage of our pipes/assets may be undergoing review and will temporarily be highlighted in yellow. If your proposed works are close to one of these pipes, you should contact the SGN Safety Admin Team on 0800 912 1722 for advice. No liability of any kind whatsoever is accepted by SGN or its agents, servants or sub-contractors for any error or omission contained herein. Safe digging practices, in accordance with HS (G)47, must be used to verify and establish the actual position of mains, pipes, services and other apparatus on site before any mechanical plant is used. It is your responsibility to ensure that plant location information is provided to all persons (whether direct labour or sub-contractors) working for you on or near gas apparatus. Information included on this plan should not be referred to beyond a period of 28 days from the date of issue.

Report damage immediately – KEEP EVERYONE AWAY FROM THE AREA
0800 111 999





This plan is reproduced from or based on the OS map by Scotia Gas Networks plc, with the sanction of the controller of HM Stationery Office. Crown Copyright Reserved. Southern Gas – 100044373 and Scotland Gas – 100044366.

High Pressure Gas Pipes within this vicinity


Stas

17

Warning: PDF designed for A4 colour print only with no page scaling

		 <p>This information is given as a guide only and its accuracy cannot be guaranteed.</p>
<p>Contact Us SGN Safety Admin Team: 0800 912 1722 Email: plantlocation@sgn.co.uk</p>		
<p>Date Requested: 19/02/2025 Job Reference: 36078720 Site Location: 604023 140875 Requested by: [REDACTED] Your Scheme/Reference: 37047-2</p>	<p>This plan shows the location of those pipes owned by Scotia Gas Networks (SGN) by virtue of being a licensed Gas Transporter (GT). Gas pipes owned by other GTs or third parties may also be present in this area but are not shown on this plan. Information with regard to such pipes should be obtained from the relevant owners. No warranties are given with regard to the accuracy of the information shown on this plan. Service pipes, valves, siphons, sub-connections etc. are not shown but their presence should be anticipated. You should be aware that a small percentage of our pipes/assets may be undergoing review and will temporarily be highlighted in yellow. If your proposed works are close to one of these pipes, you should contact the SGN Safety Admin Team on 0800 912 1722 for advice. No liability of any kind whatsoever is accepted by SGN or its agents, servants or sub-contractors for any error or omission contained herein. Safe digging practices, in accordance with HS (G)47, must be used to verify and establish the actual position of mains, pipes, services and other apparatus on site before any mechanical plant is used. It is your responsibility to ensure that plant location information is provided to all persons (whether direct labour or sub-contractors) working for you on or near gas apparatus. Information included on this plan should not be referred to beyond a period of 28 days from the date of issue.</p>	
<p>Scale: 1:1000 (When plotted at A4)</p>	<p style="text-align: center;">Report damage immediately – KEEP EVERYONE AWAY FROM THE AREA 0800 111 999</p> <p>This plan is reproduced from or based on the OS map by Scotia Gas Networks plc, with the sanction of the controller of HM Stationery Office. Crown Copyright Reserved. Southern Gas – 100044373 and Scotland Gas – 100044366.</p>	


High Pressure Gas Pipes within this vicinity

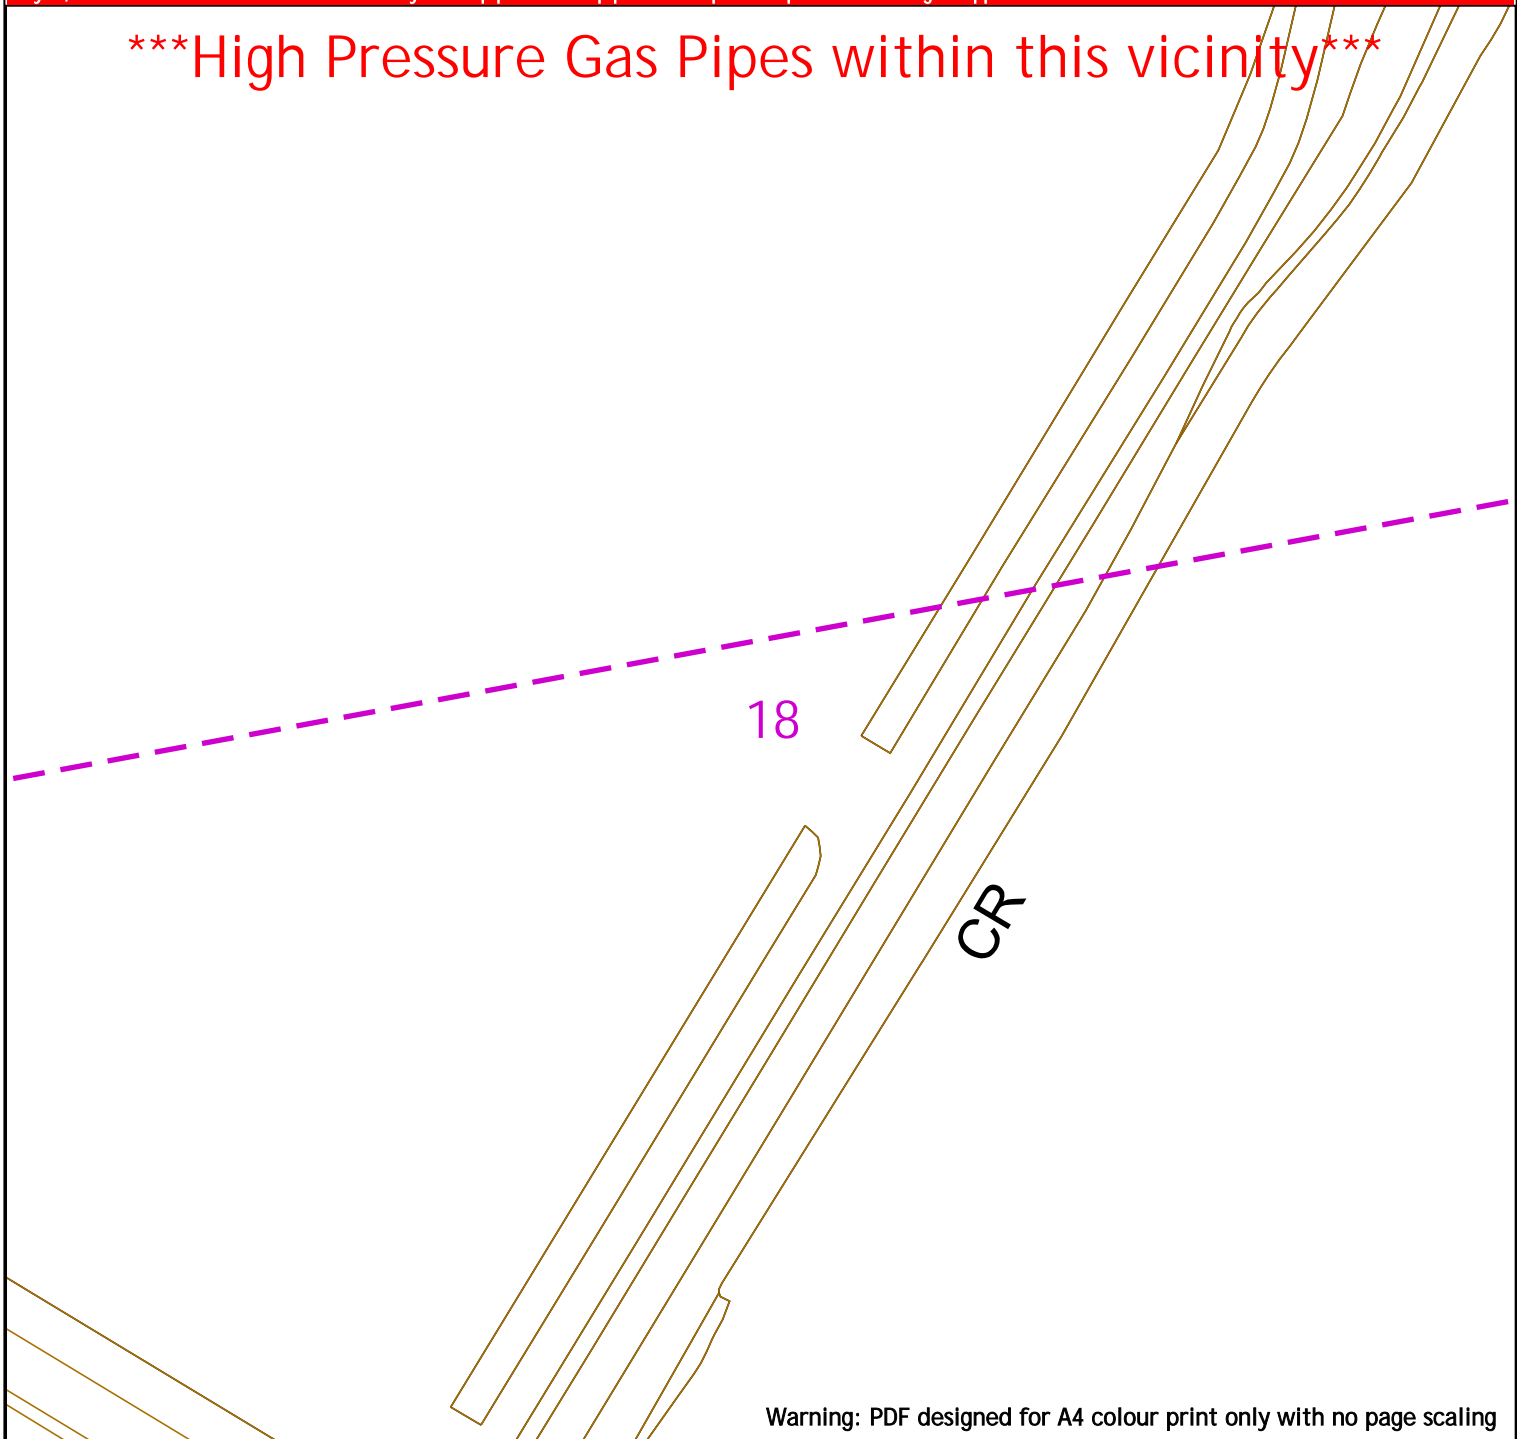

Warning: PDF designed for A4 colour print only with no page scaling



Contact Us
SGN Safety Admin Team:
 0800 912 1722
Email:
plantlocation@sgn.co.uk

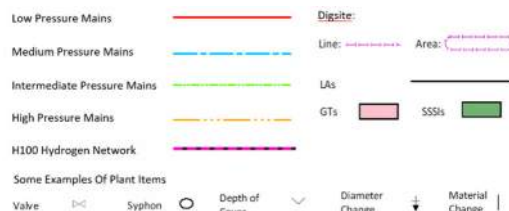

This information is given as a guide only and its accuracy cannot be guaranteed.



This plan shows the location of those pipes owned by Scotia Gas Networks (SGN) by virtue of being a licensed Gas Transporter (GT). Gas pipes owned by other GTs or third parties may also be present in this area but are not shown on this plan. Information with regard to such pipes should be obtained from the relevant owners. No warranties are given with regard to the accuracy of the information shown on this plan. Service pipes, valves, siphons, sub-connections etc. are not shown but their presence should be anticipated. You should be aware that a small percentage of our pipes/assets may be undergoing review and will temporarily be highlighted in yellow. If your proposed works are close to one of these pipes, you should contact the SGN Safety Admin Team on 0800 912 1722 for advice. No liability of any kind whatsoever is accepted by SGN or its agents, servants or sub-contractors for any error or omission contained herein. Safe digging practices, in accordance with HS (G)47, must be used to verify and establish the actual position of mains, pipes, services and other apparatus on site before any mechanical plant is used. It is your responsibility to ensure that plant location information is provided to all persons (whether direct labour or sub-contractors) working for you on or near gas apparatus. Information included on this plan should not be referred to beyond a period of 28 days from the date of issue.


Report damage immediately – KEEP EVERYONE AWAY FROM THE AREA
0800 111 999

This plan is reproduced from or based on the OS map by Scotia Gas Networks plc, with the sanction of the controller of HM Stationery Office. Crown Copyright Reserved. Southern Gas – 100044373 and Scotland Gas – 100044366.

Date Requested: 19/02/2025
 Job Reference: 36078720
 Site Location: 604023 140875
 Requested by: XXXXXXXXXX
 Your Scheme/Reference: 37047-2


Scale: 1:1000 (When plotted at A4)

High Pressure Gas Pipes within this vicinity

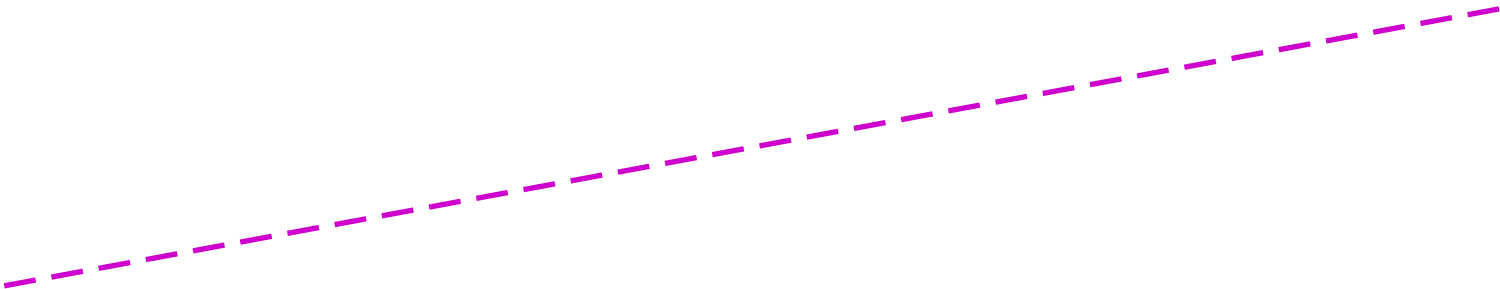

19

Warning: PDF designed for A4 colour print only with no page scaling

<div></div> <div><p>Contact Us SGN Safety Admin Team: 0800 912 1722 Email: plantlocation@sgn.co.uk</p></div>		<div><div><div>Low Pressure Mains</div><div>Medium Pressure Mains</div><div>Intermediate Pressure Mains</div><div>High Pressure Mains</div><div>H100 Hydrogen Network</div></div><div><div>Valve</div><div>Syphon</div><div>Depth of Cover</div><div>Diameter Change</div><div>Material Change</div></div></div> <div><div><div>Digsite:</div><div>Line:</div><div>LAs</div><div>GTs</div></div><div><div>SSSIs</div></div></div>
---	--	---


High Pressure Gas Pipes within this vicinity

20

Warning: PDF designed for A4 colour print only with no page scaling



Contact Us
SGN Safety Admin Team:
0800 912 1722
Email:
plantlocation@sgn.co.uk

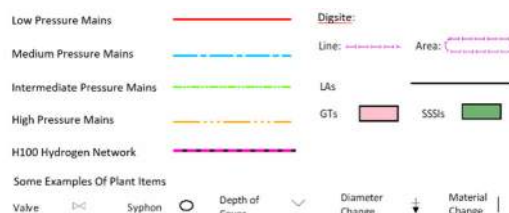

This information is given as a guide only and its accuracy cannot be guaranteed.




This plan shows the location of those pipes owned by Scotia Gas Networks (SGN) by virtue of being a licensed Gas Transporter (GT). Gas pipes owned by other GTs or third parties may also be present in this area but are not shown on this plan. Information with regard to such pipes should be obtained from the relevant owners. No warranties are given with regard to the accuracy of the information shown on this plan. Service pipes, valves, siphons, sub-connections etc. are not shown but their presence should be anticipated. You should be aware that a small percentage of our pipes/assets may be undergoing review and will temporarily be highlighted in yellow. If your proposed works are close to one of these pipes, you should contact the SGN Safety Admin Team on 0800 912 1722 for advice. No liability of any kind whatsoever is accepted by SGN or its agents, servants or sub-contractors for any error or omission contained herein. Safe digging practices, in accordance with HS (G)47, must be used to verify and establish the actual position of mains, pipes, services and other apparatus on site before any mechanical plant is used. It is your responsibility to ensure that plant location information is provided to all persons (whether direct labour or sub-contractors) working for you on or near gas apparatus. Information included on this plan should not be referred to beyond a period of 28 days from the date of issue.





Report damage immediately – KEEP EVERYONE AWAY FROM THE AREA
0800 111 999

This plan is reproduced from or based on the OS map by Scotia Gas Networks plc, with the sanction of the controller of HM Stationery Office. Crown Copyright Reserved. Southern Gas – 100044373 and Scotland Gas – 100044366.

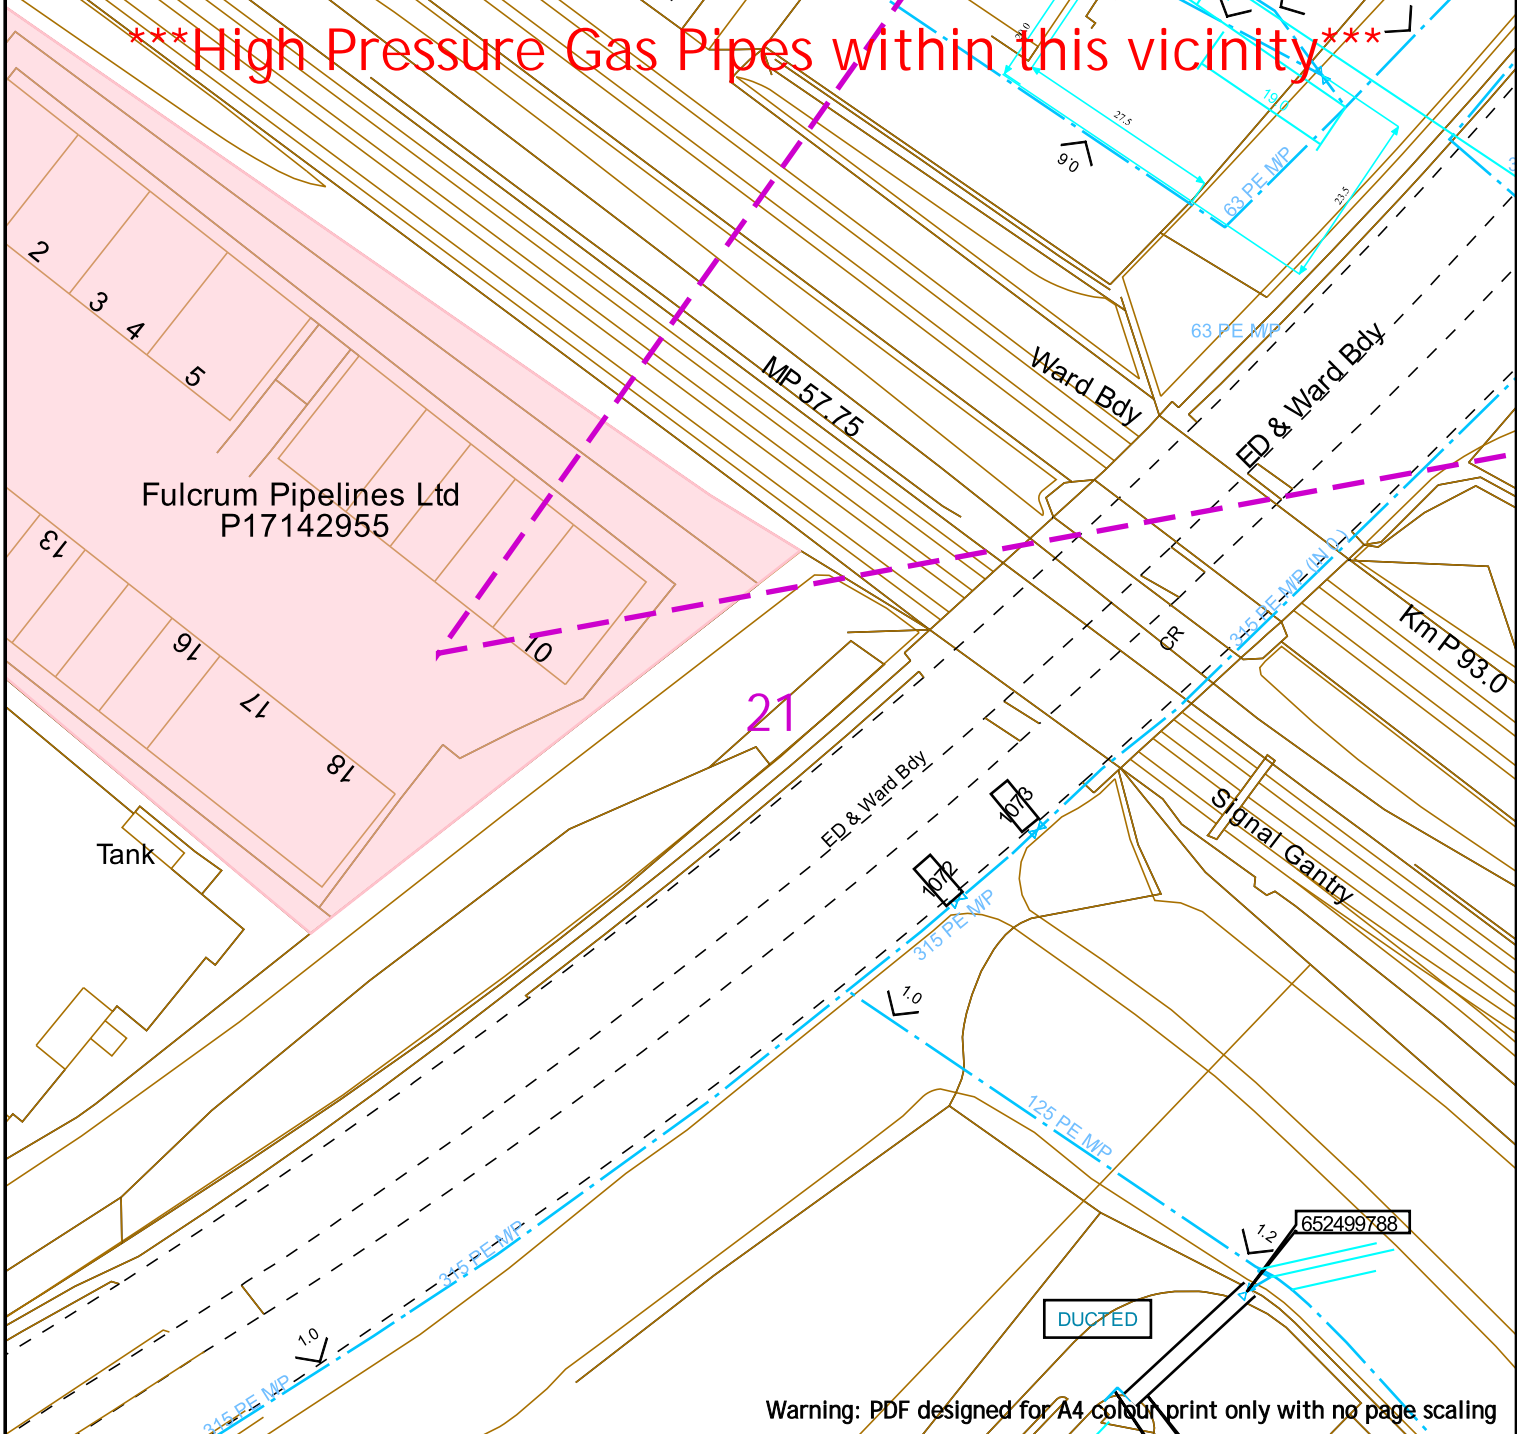
Scale: 1:1000 (When plotted at A4)

Do not proceed until spoken with the asset owner. SGN have a high-risk asset in the vicinity of these proposed works. In order to evaluate the impact of your works on our asset please could you provide further details of your work to plantlocation@sgn.co.uk or 0800111999. Please note that until we receive this information and have replied back to you, no works should occur within the vicinity of the pipeline. The pipeline is of prime importance to the gas supplies of this area.



 <p>Contact Us SGN Safety Admin Team: 0800 912 1722 Email: plantlocation@sgn.co.uk</p>	<table border="0"> <tr> <td>Low Pressure Mains</td> <td></td> <td>Dispute:</td> <td></td> </tr> <tr> <td>Medium Pressure Mains</td> <td></td> <td>Line:</td> <td></td> </tr> <tr> <td>Intermediate Pressure Mains</td> <td></td> <td>Area:</td> <td></td> </tr> <tr> <td>High Pressure Mains</td> <td></td> <td>LA's</td> <td></td> </tr> <tr> <td>H100 Hydrogen Network</td> <td></td> <td>GT's</td> <td></td> </tr> </table> <p>Some Examples Of Plant Items</p> <table border="0"> <tr> <td>Valve</td> <td></td> <td>Syphon</td> <td></td> <td>Depth of Cover</td> <td></td> <td>Diameter Change</td> <td></td> <td>Material Change</td> <td></td> </tr> </table>	Low Pressure Mains		Dispute:		Medium Pressure Mains		Line:		Intermediate Pressure Mains		Area:		High Pressure Mains		LA's		H100 Hydrogen Network		GT's		Valve		Syphon		Depth of Cover		Diameter Change		Material Change		 <p>This information is given as a guide only and its accuracy cannot be guaranteed.</p> 
Low Pressure Mains		Dispute:																														
Medium Pressure Mains		Line:																														
Intermediate Pressure Mains		Area:																														
High Pressure Mains		LA's																														
H100 Hydrogen Network		GT's																														
Valve		Syphon		Depth of Cover		Diameter Change		Material Change																								
<p>Date Requested: 19/02/2025 Job Reference: 36078720 Site Location: 604023 140875 Requested by:  Your Scheme/Reference: 37047-2</p>	<p>This plan shows the location of those pipes owned by Scotia Gas Networks (SGN) by virtue of being a licensed Gas Transporter (GT). Gas pipes owned by other GTs or third parties may also be present in this area but are not shown on this plan. Information with regard to such pipes should be obtained from the relevant owners. No warranties are given with regard to the accuracy of the information shown on this plan. Service pipes, valves, siphons, sub-connections etc. are not shown but their presence should be anticipated. You should be aware that a small percentage of our pipes/assets may be undergoing review and will temporarily be highlighted in yellow. If your proposed works are close to one of these pipes, you should contact the SGN Safety Admin Team on 0800 912 1722 for advice. No liability of any kind whatsoever is accepted by SGN or its agents, servants or sub-contractors for any error or omission contained herein. Safe digging practices, in accordance with HS (G)47, must be used to verify and establish the actual position of mains, pipes, services and other apparatus on site before any mechanical plant is used. It is your responsibility to ensure that plant location information is provided to all persons (whether direct labour or sub-contractors) working for you on or near gas apparatus. Information included on this plan should not be referred to beyond a period of 28 days from the date of issue.</p> <p style="text-align: center;">Report damage immediately – KEEP EVERYONE AWAY FROM THE AREA 0800 111 999</p> <p style="text-align: center; font-size: small;">This plan is reproduced from or based on the OS map by Scotia Gas Networks plc, with the sanction of the controller of HM Stationery Office. Crown Copyright Reserved. Southern Gas – 100044373 and Scotland Gas – 100044366.</p>																															

Scale: 1:1000 (When plotted at A4)

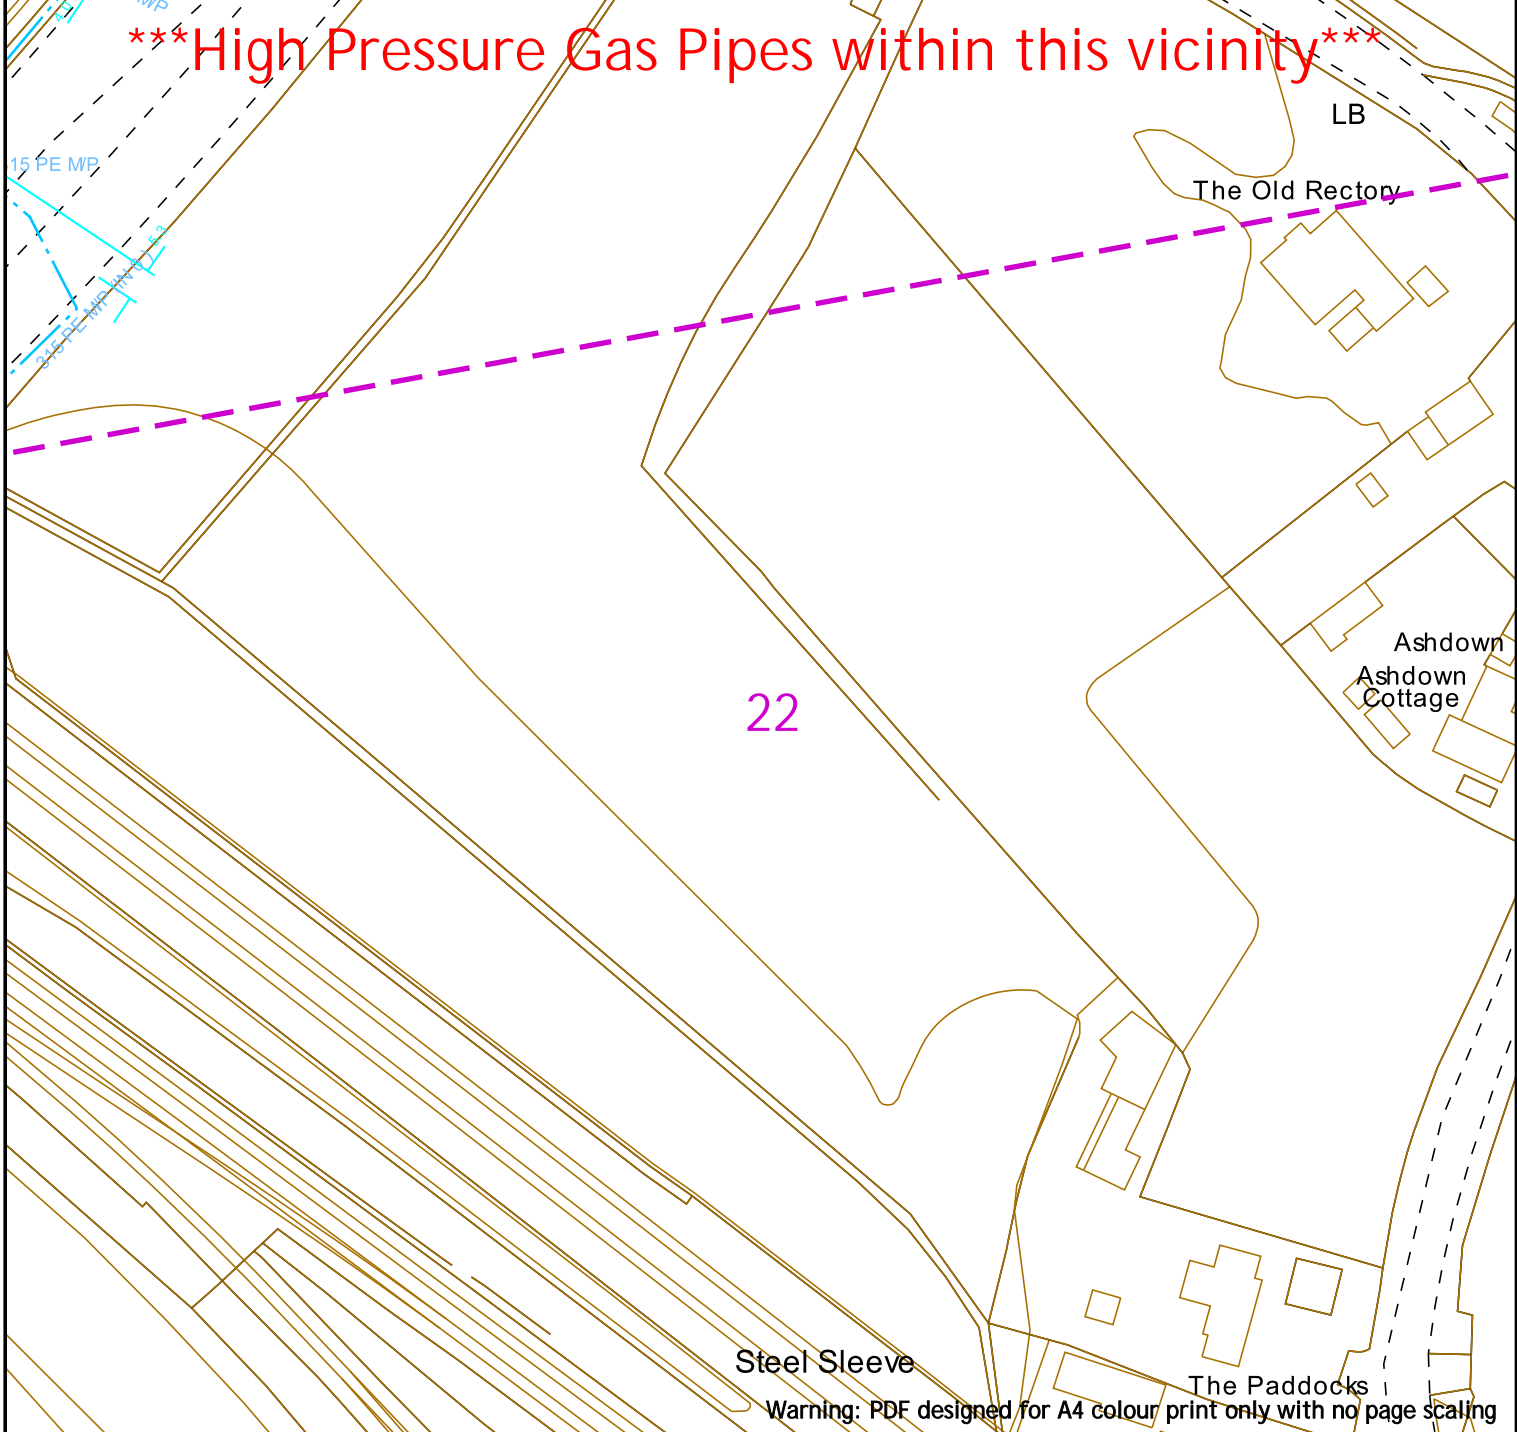

Contact Us
SGN Safety Admin Team:
 0800 912 1722
Email:
plantlocation@sgn.co.uk

Low Pressure Mains		Digite:	
Medium Pressure Mains		Line:	
Intermediate Pressure Mains		LA's	
High Pressure Mains		GT's	
H100 Hydrogen Network		SSS's	
Some Examples Of Plant Items			
Valve		Syphon	
Depth of Cover		Diameter Change	
		Material Change	



This information is given as a guide only and its accuracy cannot be guaranteed.




This plan shows the location of those pipes owned by Scotia Gas Networks (SGN) by virtue of being a licensed Gas Transporter (GT). Gas pipes owned by other GTs or third parties may also be present in this area but are not shown on this plan. Information with regard to such pipes should be obtained from the relevant owners. No warranties are given with regard to the accuracy of the information shown on this plan. Service pipes, valves, siphons, sub-connections etc. are not shown but their presence should be anticipated. You should be aware that a small percentage of our pipes/assets may be undergoing review and will temporarily be highlighted in yellow. If your proposed works are close to one of these pipes, you should contact the SGN Safety Admin Team on 0800 912 1722 for advice. No liability of any kind whatsoever is accepted by SGN or its agents, servants or sub-contractors for any error or omission contained herein. Safe digging practices, in accordance with HS (G)47, must be used to verify and establish the actual position of mains, pipes, services and other apparatus on site before any mechanical plant is used. It is your responsibility to ensure that plant location information is provided to all persons (whether direct labour or sub-contractors) working for you on or near gas apparatus. Information included on this plan should not be referred to beyond a period of 28 days from the date of issue.

Report damage immediately – KEEP EVERYONE AWAY FROM THE AREA
0800 111 999

This plan is reproduced from or based on the OS map by Scotia Gas Networks plc, with the sanction of the controller of HM Stationery Office. Crown Copyright Reserved. Southern Gas – 100044373 and Scotland Gas – 100044366.

Date Requested: 19/02/2025
 Job Reference: 36078720
 Site Location: 604023 140875
 Requested by: XXXXXXXXXX
 Your Scheme/Reference: 37047-2

Scale: 1:1000 (When plotted at A4)

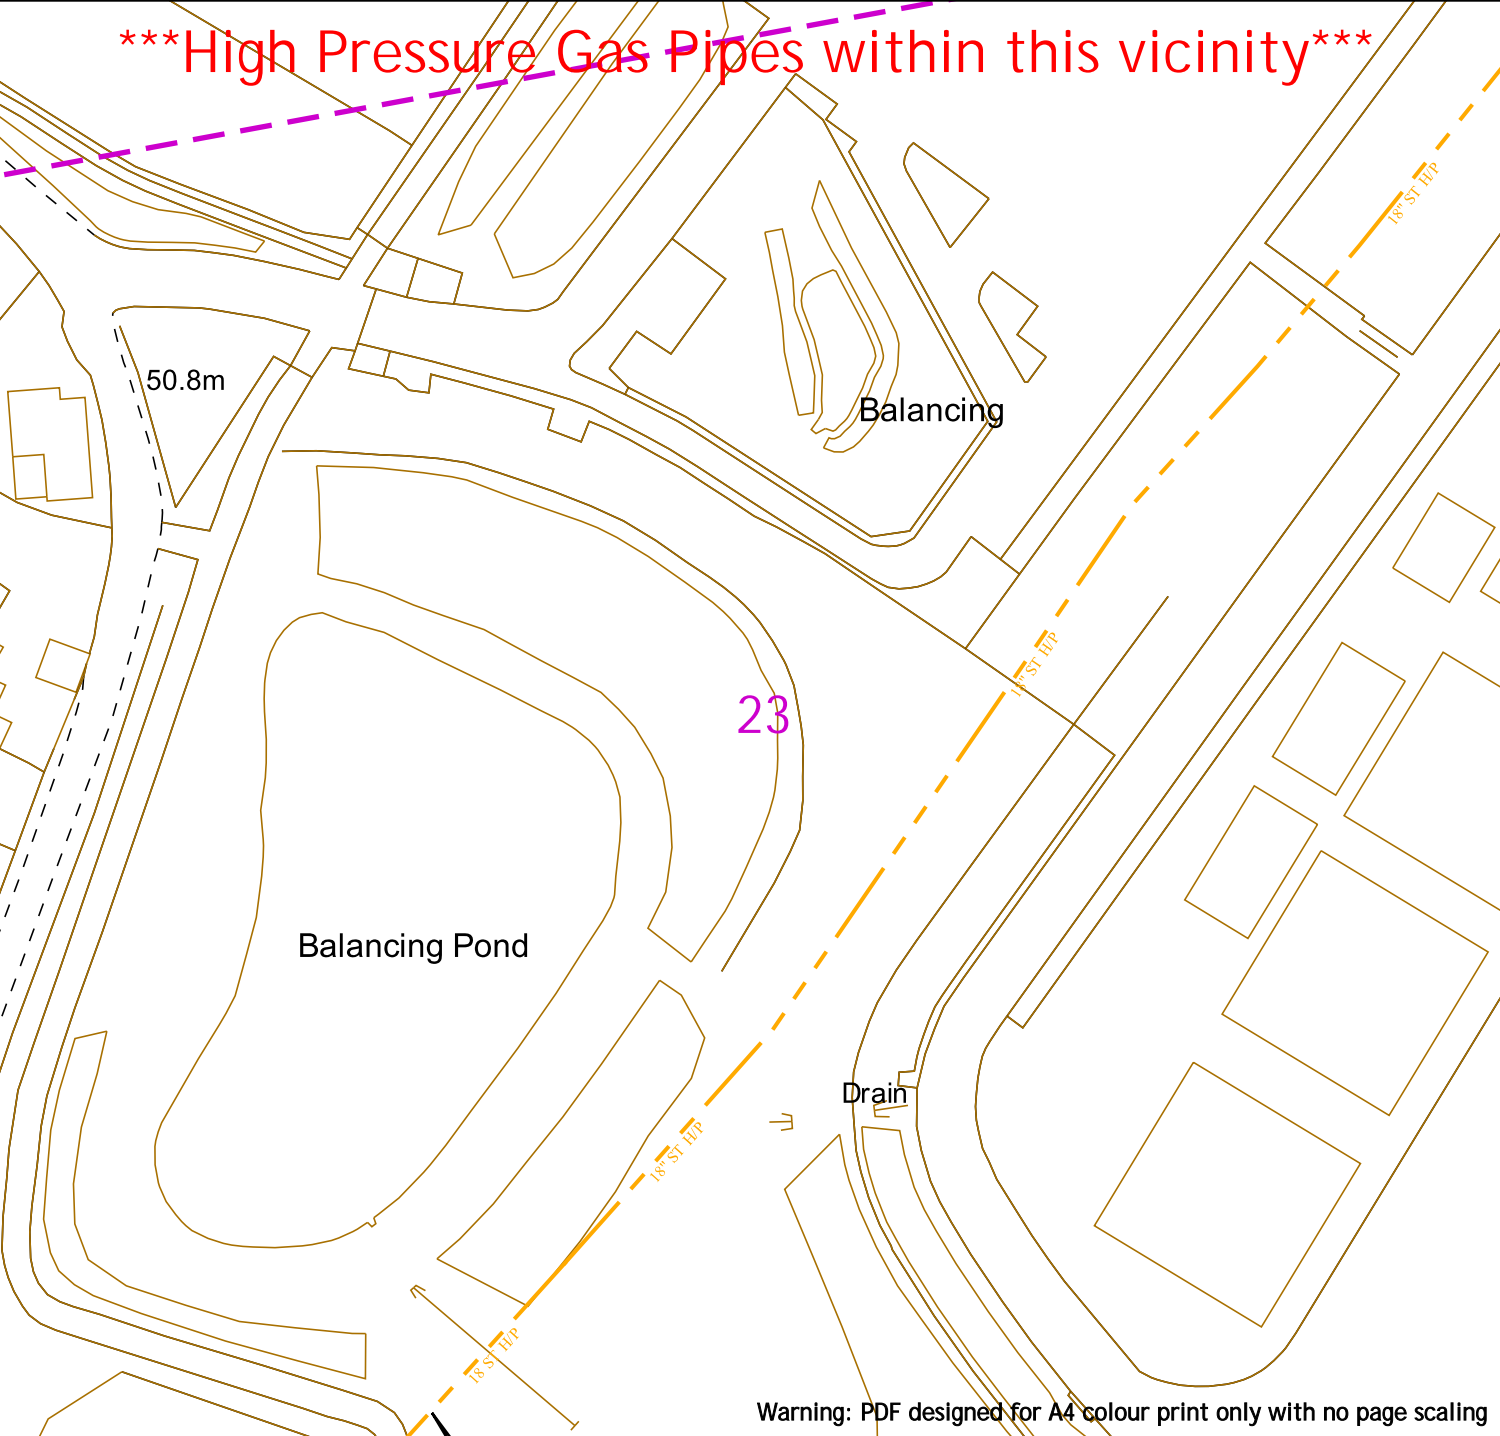

Contact Us
SGN Safety Admin Team:
0800 912 1722
Email:
plantlocation@sgn.co.uk


Some Examples Of Plant Items

Valve		Syphon		Depth of Cover		Diameter Change		Material Change	
-------	--	--------	--	----------------	--	-----------------	--	-----------------	--

This information is given as a guide only and its accuracy cannot be guaranteed.

This plan shows the location of those pipes owned by Scotia Gas Networks (SGN) by virtue of being a licensed Gas Transporter (GT). Gas pipes owned by other GTs or third parties may also be present in this area but are not shown on this plan. Information with regard to such pipes should be obtained from the relevant owners. No warranties are given with regard to the accuracy of the information shown on this plan. Service pipes, valves, siphons, sub-connections etc. are not shown but their presence should be anticipated. You should be aware that a small percentage of our pipes/assets may be undergoing review and will temporarily be highlighted in yellow. If your proposed works are close to one of these pipes, you should contact the SGN Safety Admin Team on 0800 912 1722 for advice. No liability of any kind whatsoever is accepted by SGN or its agents, servants or sub-contractors for any error or omission contained herein. Safe digging practices, in accordance with HS (G)47, must be used to verify and establish the actual position of mains, pipes, services and other apparatus on site before any mechanical plant is used. It is your responsibility to ensure that plant location information is provided to all persons (whether direct labour or sub-contractors) working for you on or near gas apparatus. Information included on this plan should not be referred to beyond a period of 28 days from the date of issue.


Report damage immediately – KEEP EVERYONE AWAY FROM THE AREA
0800 111 999

Scale: 1:1000 (When plotted at A4)


This plan is reproduced from or based on the OS map by Scotia Gas Networks plc, with the sanction of the controller of HM Stationery Office. Crown Copyright Reserved. Southern Gas – 100044373 and Scotland Gas – 100044366.

5. Fulcrum

The following site utility layouts have been directly obtained from Groundwise Searches Ltd which depicts the present electrical utilities within the vicinity of the IBC site boundary.

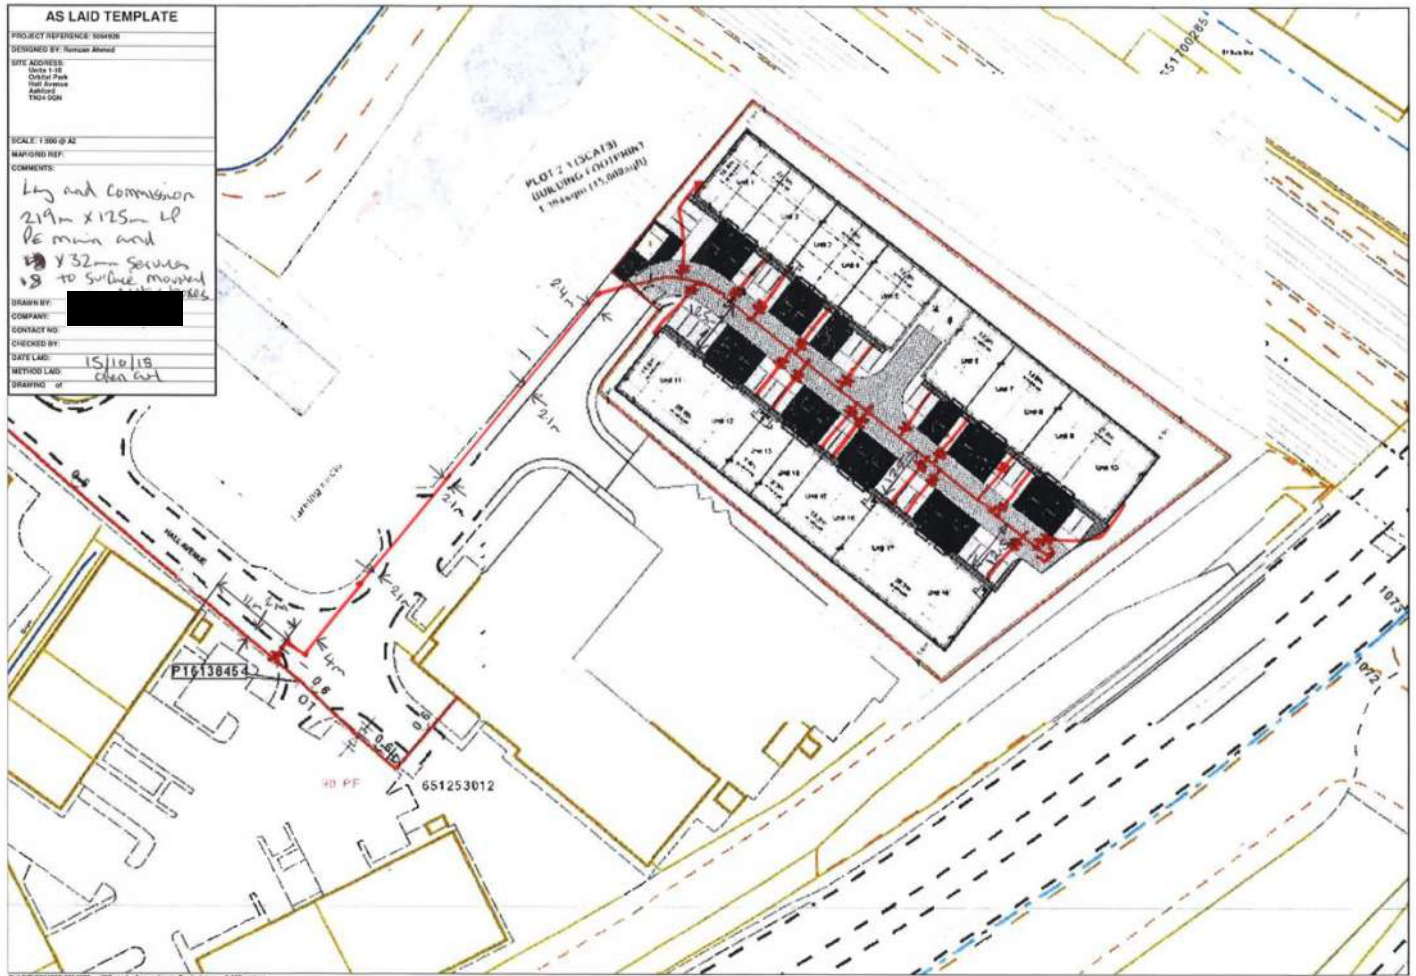




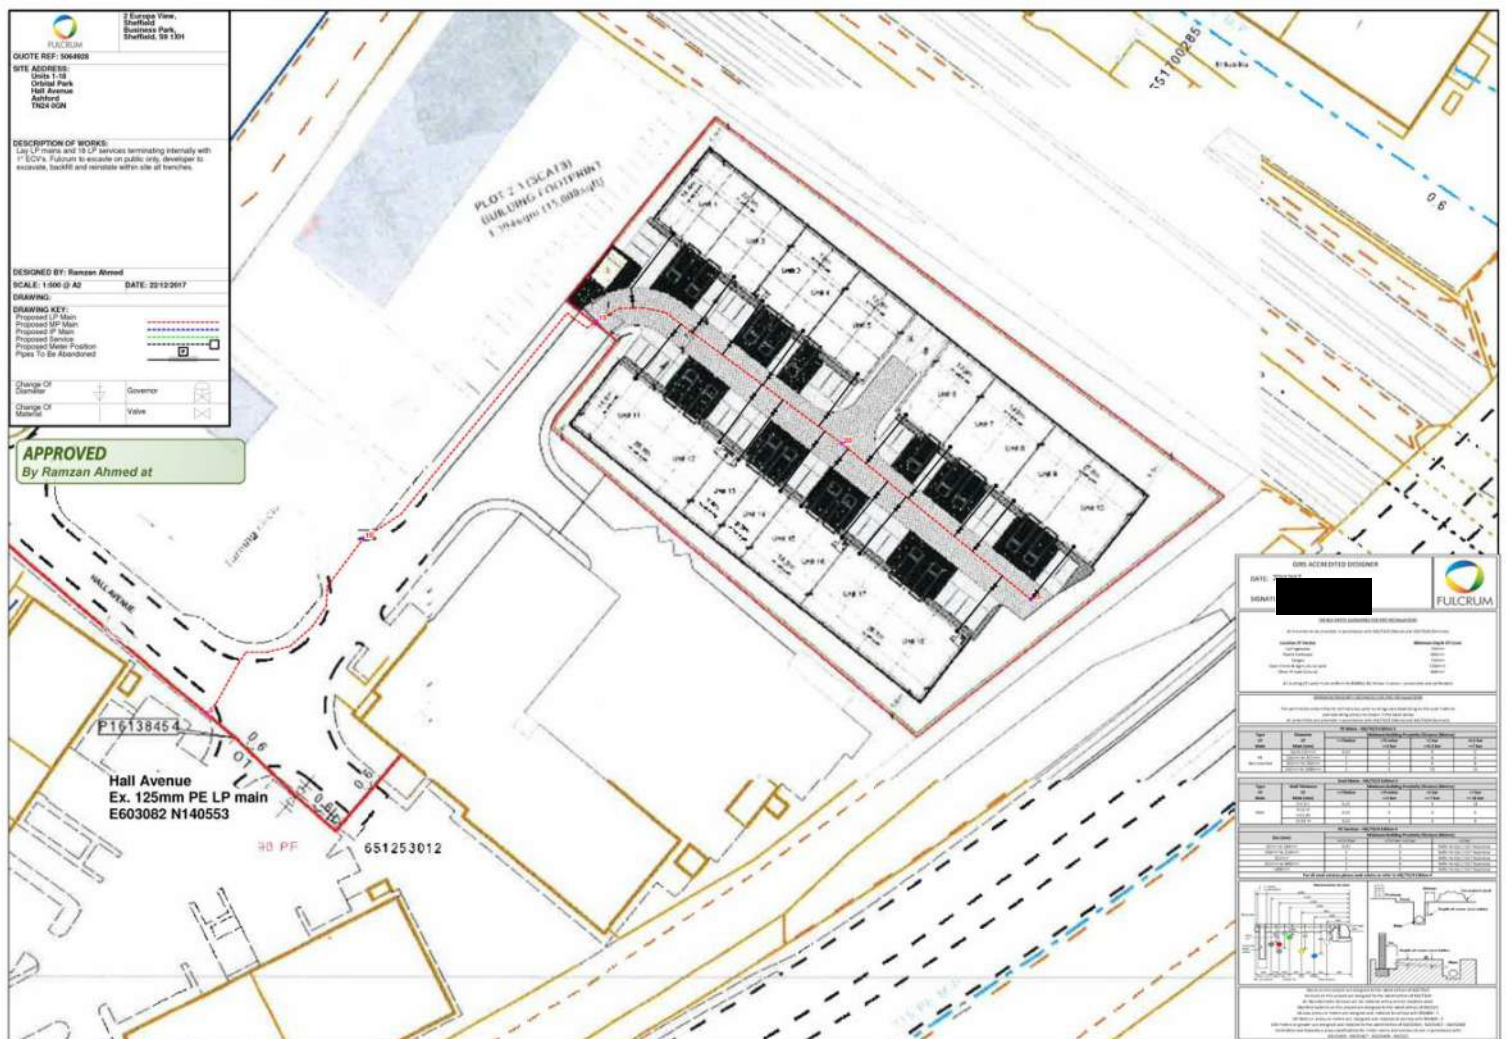


6. Openreach

The following site utility layouts have been directly obtained from Groundwise Searches Ltd which depicts the present telecommunications utilities within the vicinity of the IBC site boundary.

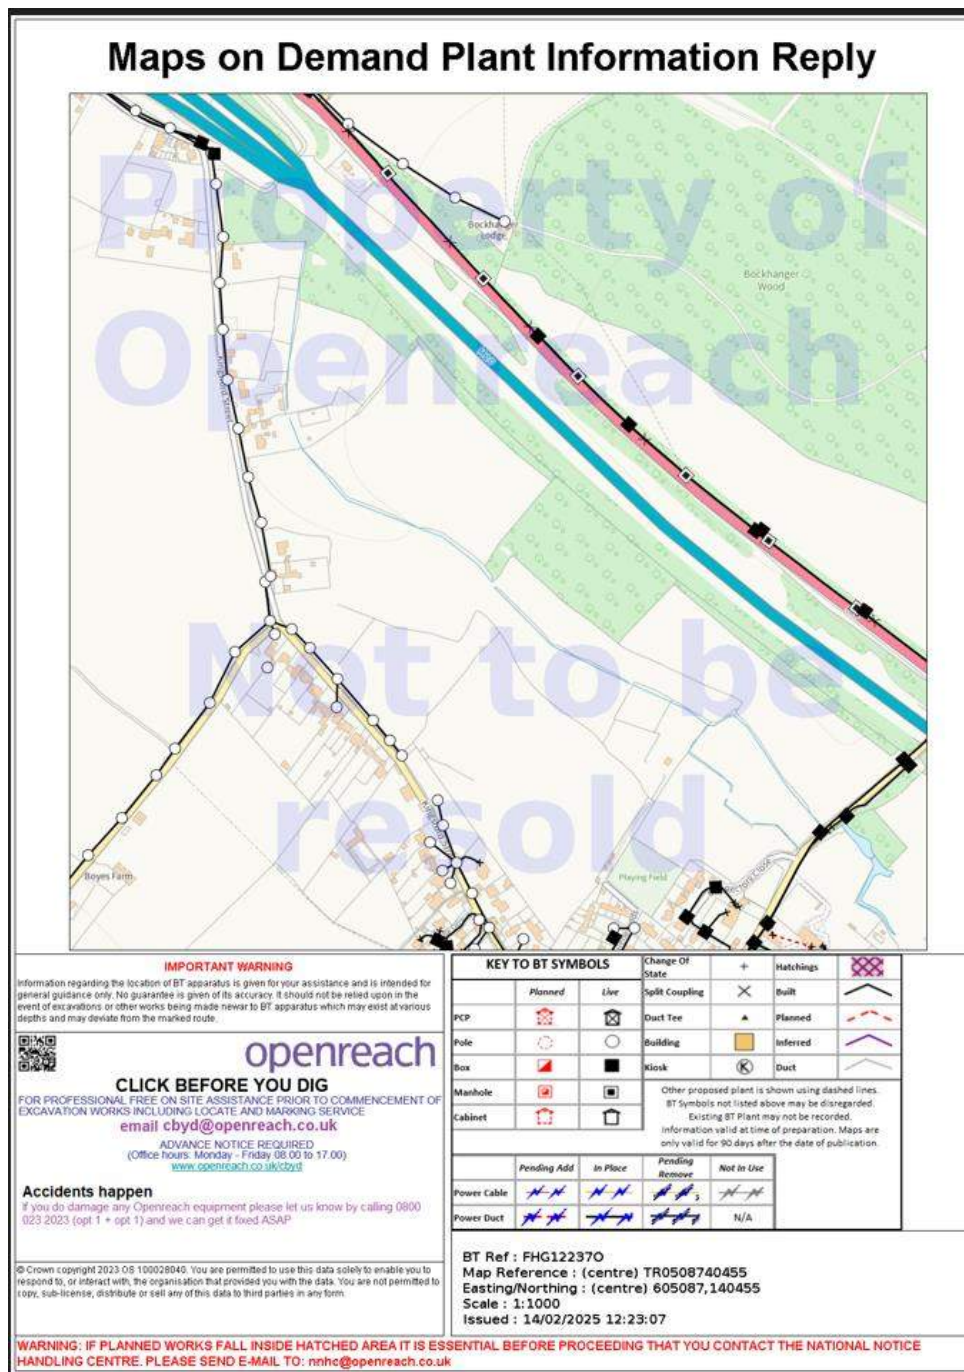

Maps on Demand Plant Information Reply

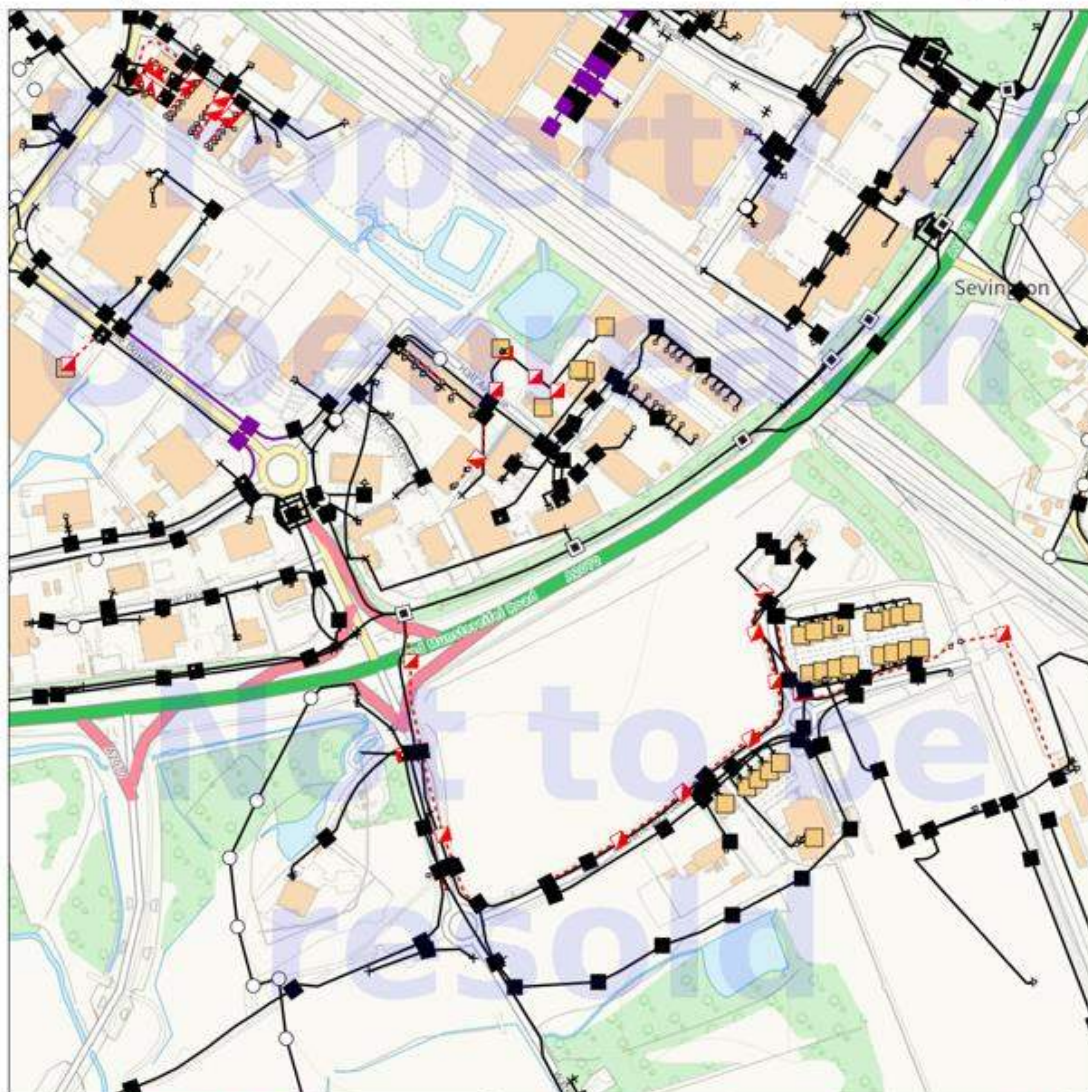

IMPORTANT WARNING

Information regarding the location of BT apparatus is given for your assistance and is intended for general guidance only. No guarantee is given of its accuracy. It should not be relied upon in the event of excavations or other works being made near to BT apparatus which may exist at various depths and may deviate from the marked route.



openreach

CLICK BEFORE YOU DIG

FOR PROFESSIONAL FREE ON SITE ASSISTANCE PRIOR TO COMMENCEMENT OF EXCAVATION WORKS INCLUDING LOCATE AND MARKING SERVICE

email cbyd@openreach.co.uk

ADVANCE NOTICE REQUIRED
(Office hours: Monday - Friday 08.00 to 17.00)
www.openreach.co.uk/cbyd

Accidents happen

If you do damage any Openreach equipment please let us know by calling 0800 023 2023 (opt 1 + opt 1) and we can get it fixed ASAP

© Crown copyright 2023 OS 100028040. You are permitted to use this data solely to enable you to respond to, or interact with, the organisation that provided you with the data. You are not permitted to copy, sub-license, distribute or sell any of this data to third parties in any form.

KEY TO BT SYMBOLS

	Planned	Live	Change Of State	+	Hatchings
PCP			Split Coupling		Built
Pole			Duct Tee		Planned
Box			Building		Inferred
Manhole			Kiosk		Duct
Cabinet			Other proposed plant is shown using dashed lines. BT Symbols not listed above may be disregarded. Existing BT Plant may not be recorded. Information valid at time of preparation. Maps are only valid for 90 days after the date of publication.		
	Pending Add	In Place	Pending Remove	Not In Use	
Power Cable					
Power Duct				N/A	

BT Ref : UZX12234V

Map Reference : (centre) TR0308740455

Easting/Northing : (centre) 603087,140455

Scale : 1:1000

Issued : 14/02/2025 12:23:34

WARNING: IF PLANNED WORKS FALL INSIDE HATCHED AREA IT IS ESSENTIAL BEFORE PROCEEDING THAT YOU CONTACT THE NATIONAL NOTICE HANDLING CENTRE. PLEASE SEND E-MAIL TO: nnhc@openreach.co.uk

Maps on Demand Plant Information Reply



IMPORTANT WARNING

Information regarding the location of BT apparatus is given for your assistance and is intended for general guidance only. No guarantee is given of its accuracy. It should not be relied upon in the event of excavations or other works being made near to BT apparatus which may exist at various depths and may deviate from the marked route.



openreach

CLICK BEFORE YOU DIG

FOR PROFESSIONAL FREE ON SITE ASSISTANCE PRIOR TO COMMENCEMENT OF EXCAVATION WORKS INCLUDING LOCATE AND MARKING SERVICE

email cbyd@openreach.co.uk

ADVANCE NOTICE REQUIRED
(Office hours: Monday - Friday 08.00 to 17.00)
www.openreach.co.uk/cbyd

Accidents happen

If you do damage any Openreach equipment please let us know by calling 0800 023 2023 (opt 1 + opt 13) and we can get it fixed ASAP

© Crown copyright 2023 OS 100028040. You are permitted to use this data solely to enable you to respond to, or interact with, the organisation that provided you with the data. You are not permitted to copy, sub-license, distribute or sell any of this data to third parties in any form.

KEY TO BT SYMBOLS

	Planned	Live	Change Of State	+	Hatchings
PCP			Split Coupling		Built
Pole			Duct Tee		Planned
Box			Building		Inferred
Manhole			Kiosk		Duct
Cabinet			Other proposed plant is shown using dashed lines. BT Symbols not listed above may be disregarded. Existing BT Plant may not be recorded. Information valid at time of preparation. Maps are only valid for 90 days after the date of publication.		
	Pending Add	In Place	Pending Remove	Not In Use	
Power Cable					
Power Duct				N/A	

BT Ref : VFE12210W

Map Reference : (centre) TR0408740455

Easting/Northing : (centre) 604087,140455

Scale : 1:1000

Issued : 14/02/2025 12:21:55

WARNING: IF PLANNED WORKS FALL INSIDE HATCHED AREA IT IS ESSENTIAL BEFORE PROCEEDING THAT YOU CONTACT THE NATIONAL NOTICE HANDLING CENTRE. PLEASE SEND E-MAIL TO: nnhc@openreach.co.uk

7. HSE

The following site utility layouts have been directly obtained from Groundwise Searches Ltd which depicts the present utilities within the vicinity of the IBC site boundary that require HSE to be involved.

Suite 6, Princess Caroline House, 1 High Street, Southend on Sea, Essex, SS1 1JE




Advice : HSL-250214122614-963 Crosses Consultation Zone

Please enter further details about the proposed development by continuing with the enquiry on the HSE's Planning Advice Web App from the Previous Enquiries tab either now or at a later time, unless the Web App has stopped the process and notified you to contact HSE.

Your Ref: 37047DM-GWS

Development Name: Land at A2070, Ashford, TN25 6GE

Comments: STUDY

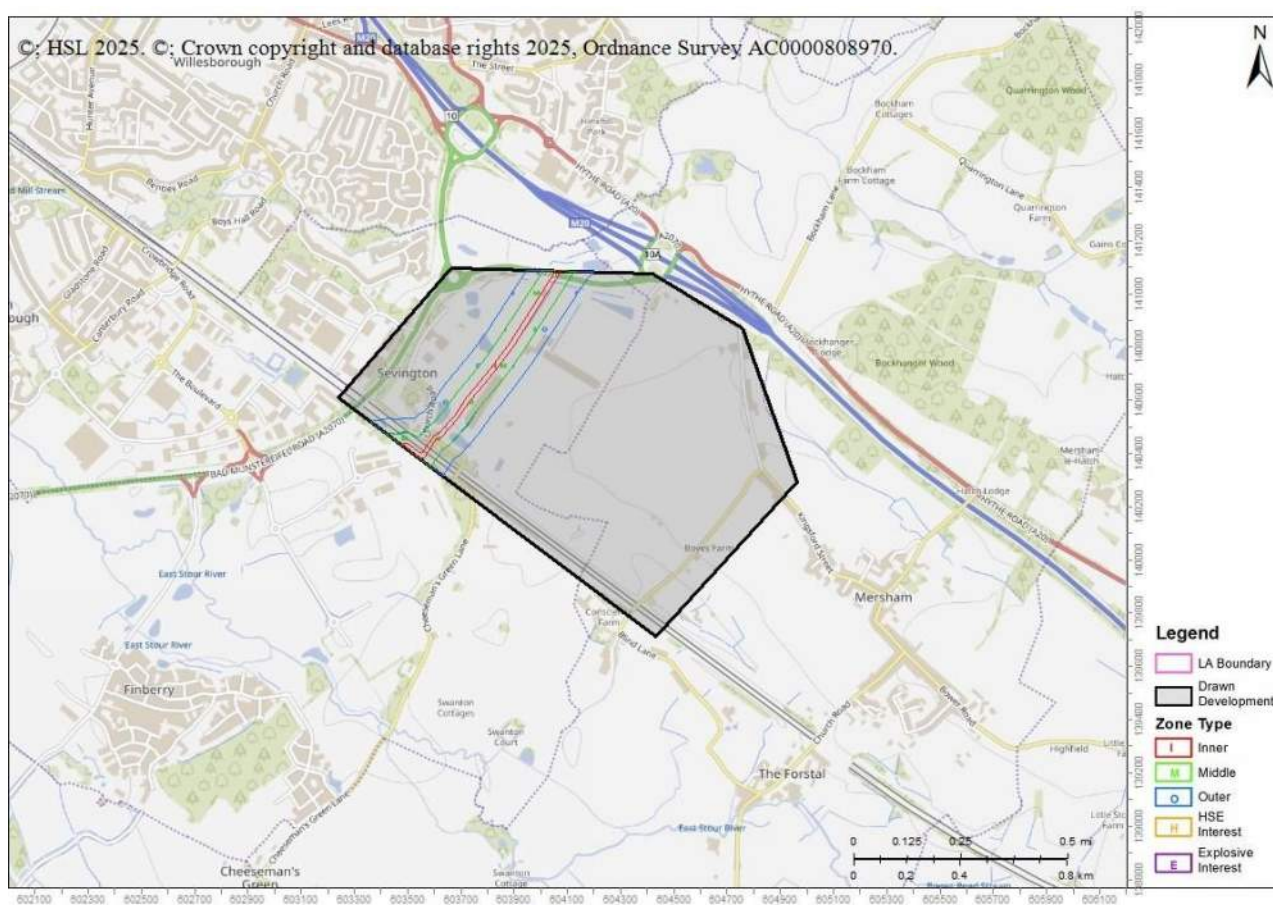

The proposed development site which you have identified currently lies within the consultation distance (CD) of at least one major hazard site and/or major accident hazard pipeline; HSE needs to be consulted on any developments on this site.

This advice report has been generated using information supplied by Debbie Miller at Groundwise Searches Ltd on 14 February 2025.

You will also need to contact the pipeline operator as they may have additional constraints on development near their pipeline.

- 7110_1381 Southern Gas Networks

HSL/HSE accepts no liability for the accuracy of the pipeline routing data received from a 3rd party. HSE/HSL

also accepts no liability if you do not consult with the pipeline operator.

You may wish to contact HSE's Planning Advice team to discuss the above enquiry result on 0203 028 3708 or by email at lupenquiries@hse.gov.uk.

8. South East water

The following site utility layouts have been directly obtained from Groundwise Searches Ltd which depicts the present water utilities within the vicinity of the IBC site boundary.

9. Southern Water

The following site utility layouts have been directly obtained from Groundwise Searches Ltd which depicts the present drainage utilities within the vicinity of the IBC site boundary.

[illegible]

Wholesale Reference	Liquid Type	Cover Level	Invert Level	Depth to Invert
01001	F	44.05	40.69	
01002	F	44.60	41.75	
01003	F	44.28	41.58	
02004	F	44.60	41.53	
02005	F	0.00	0.00	
02006	F	42.62	40.85	
03001	F	40.62	39.92	
03002	F	40.70	38.90	
05001	F	40.06	38.38	
05002	F	39.78	37.99	
06001	F	39.20	36.20	
10001	F	44.42	42.50	
10002	F	44.50	42.80	
11001	F	43.83	41.73	
11002	F	43.47	41.52	
12000	F	43.40	41.40	
12003	F	43.21	41.22	
12004	F	0.00	0.00	
12005	F	41.62	39.19	
12006	F	42.66	41.06	
12007	F	42.63	40.42	
12008	F	40.81	38.85	
13001	F	45.58	44.37	
13002	F	43.72	41.34	
13003	F	42.26	39.59	
15001	F	40.77	38.67	
15002	F	40.25	38.70	
16001	F	41.92	39.50	
19002	F	0.00	0.00	
19003	F	0.00	0.00	
20001	F	44.77	42.77	
20002	F	46.91	43.70	
21001	F	41.45	40.32	
22001	F	45.54	44.31	
22002	F	43.40	42.40	
22003	F	43.82	41.91	
22004	F	44.23	41.98	
23001	F	47.64	45.71	
23002	F	46.44	45.20	
23003	F	47.51	45.38	
23004	F	46.85	45.74	
23005	F	46.83	45.19	
30002	F	44.29	42.24	
31001	F	41.68	40.79	
31002	F	43.21	41.36	
31003	F	43.46	41.52	
32001	F	43.85	42.14	
32002	F	44.74	43.66	
32003	F	45.00	43.56	
32004	F	44.20	42.40	
33001	F	46.10	43.40	
33002	F	47.06	43.24	
33003	F	44.70	44.70	
39001	F	47.37	44.90	
40001	F	45.02	0.00	
41001	F	0.00	0.00	
41002	F	43.09	41.27	
41003	F	43.09	40.95	
41004	F	43.28	40.83	
41005	F	43.20	40.51	
41006	F	43.16	41.18	
42000	F	42.66	0.00	
42001	F	44.22	42.66	
42003	F	43.80	42.78	
42004	F	43.14	39.82	
42005	F	42.66	39.39	
43001	F	47.26	0.00	
43002	F	47.15	42.83	
43003	F	44.44	42.69	
43004	F	45.26	0.00	
43005	F	44.09	44.08	
43006	F	48.11	45.30	
43007	F	46.31	42.66	
51001	F	42.87	40.75	
51002	F	42.80	40.15	
51003	F	42.97	40.24	
51004	F	45.90	44.20	
51005	F	46.16	44.56	
51006	F	46.13	44.11	
51007	F	47.02	43.94	
51008	F	45.57	43.33	
51009	F	43.04	0.00	
51011	F	43.14	40.99	
51112	F	43.20	40.48	
51113	F	0.00	0.00	
52001	F	42.82	39.17	
52002	F	43.07	40.12	
52003	F	0.00	0.00	
53001	F	45.49	42.11	
53002	F	44.71	41.55	
53003	F	43.76	40.96	
53004	F	43.38	40.87	
53005	F	43.30	40.70	
53006	F	41.85	40.40	
53007	F	39.10	36.05	
05500	S	40.00	37.73	
05501	S	39.62	37.66	
05502	S	39.47	37.64	
05503	S	39.31	37.60	
11500	S	40.33	40.06	
11501	S	40.75	39.91	
11502	S	40.64	39.78	
11503	S	40.43	39.83	
13501	S	45.11	42.72	
13502	S	43.80	41.51	
15500	S	40.90	38.62	
15501	S	40.23	37.76	
16500	S	41.84	38.90	
16501	S	41.48	38.79	
22501	S	45.43	43.10	
22502	S	43.14	41.64	
22503	S	42.85	40.68	
22504	S	42.37	40.54	
23500	S	47.63	45.19	
23501	S	46.41	44.52	
23502	S	46.29	45.12	
23503	S	47.48	46.38	
23504	S	46.70	45.46	
31502	S	43.13	41.61	
31503	S	43.26	41.53	
31504	S	43.00	41.78	
32501	S	44.81	44.06	
32502	S	44.71	43.94	
32503	S	44.96	43.74	
33501	S	45.98	43.71	
33502	S	47.16	43.64	
41501	S	43.06	41.49	
41502	S	42.88	41.51	
41503	S	43.13	41.38	
42501	S	43.24	41.01	
42502	S	43.97	41.13	
42503	S	44.03	41.06	
42504	S	44.14	40.95	
42505	S	43.79	41.31	
42507	S	44.16	40.97	
42508	S	43.85	41.15	
43501	S	44.94	43.40	
43502	S	46.18	44.48	
43503	S	47.35	43.40	
43504	S	47.25	43.30	
43505	S	46.53	43.15	
43506	S	45.44	43.08	
43507	S	44.61	42.32	
43508	S	48.22	46.21	
50501	S	46.45	46.88	
50502	S	47.22	45.55	
50503	S	48.14	46.83	
51500	S	45.82	43.42	
51501	S	47.95	46.17	
51502	S	46.27	44.39	
51503	S	47.11	44.02	
51504	S	46.16	43.86	
51505	S	45.72	43.34	
51506	S	43.20	41.47	
51507	S	42.99	40.92	
51508	S	42.84	40.86	
51509	S	43.01	41.15	
51600	S	42.92	41.45	
51602	S	43.79	41.69	
51603	S	42.94	41.18	
52501	S	43.16	42.27	
52503	S	42.99	41.35	
52504	S	43.66	40.77	
52505	S	43.33	41.33	
52506	S	43.50	40.88	
52509	S	43.70	40.81	
52508	S	43.68	40.81	
52507	S	43.64	40.76	
52605	S	43.74	40.80	
52606	S	43.65	40.75	
52607	S	43.70	40.75	
52608	S	43.51	40.81	
52609	S	43.13	41.63	
52700	S	43.70	40.80	
52701	S	43.34	40.94	
52704	S	42.88	40.82	
53501	S	45.33	43.73	
53502	S	43.90	42.16	
53503	S	43.49	42.80	
53504	S	43.77	41.09	
53505	S	44.63	42.06	
53506	S	43.27	41.60	
53507	S	45.35	42.93	
92500	S	44.61	43.21	
96504	S	39.15	37.34	

We are Waterman, where every project matters

We deliver progressive, sustainability-driven environmental and engineering consultancy services across every sector. We think differently, and we're harnessing our collective expertise to deliver greener, healthier and well-connected communities, networks and built environments.

Based in strategic locations throughout the UK and Ireland, our team of specialists is at the forefront of tackling the climate emergency and forging a path to a Net Zero built environment.

UK & Ireland Office Locations

